


**CERTIFIED RECORD OF LAND CORNER MONUMENTATION**

**HISTORY OF ORIGINAL CORNER ESTABLISHMENT:**

Corner originally established by Chris Palmer, in Survey filed as M-045-C (also 03-274-C).

T 1 N R 35 E Q-01

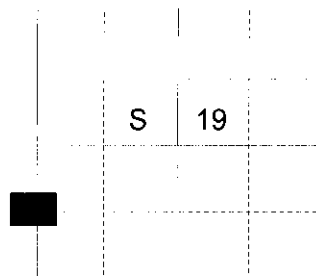

**DESCRIPTION OF CORNER EVIDENCE FOUND:**

Found 1 1/2" iron pipe with 2" brass cap North 85°36'09" West, a distance of 21.55 from true corner position, set by Chris Palmer in Survey Number M-045-C.

**DESCRIPTION OF MONUMENT AND ACCESSORIES I ESTABLISHED TO PERPETUATE THE ORIGINAL LOCATION OF THIS CORNER:**

At position established by survey, I set a 5/8" x 30" iron rebar with a 2 1/2" aluminum cap marked as shown below, 30 inches in the ground, from which:


- A 6 inch White Fir bears South 19° East, a distance of 22.15 feet, marked S 1/16 S19 BT.
- A 13 inch White Fir bears North 69° West, a distance of 36.50 feet, marked S 1/16 S24 BT.

Corner falls approximately 30 feet South of a logging road. I set a steel fencepost 1 ft. West of corner monument.

I hereby certify that the corner was perpetuated on September 10, 2013.



Renewal Date: June 30, 2015

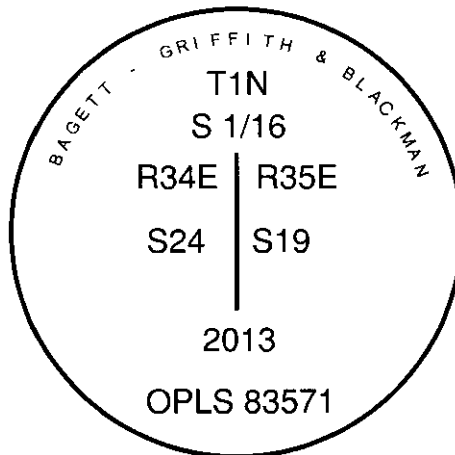

I used a steel tape and magnetic compass in the establishment of the bearing trees. Magnetic declination used was 16° East. Bearings are to a washer marked OPLS 83571 in the lower BT blaze.

**RECEIVED BY**

Umatilla County Surveyor

Date: 9/20/2013

Rec'd By: *Jay Palmer*

No.: 13-521-B