


CERTIFIED RECORD OF LAND CORNER MONUMENTATION

HISTORY OF ORIGINAL CORNER ESTABLISHED:

Corner not previously established.

T 1 N R 35 E Q-20

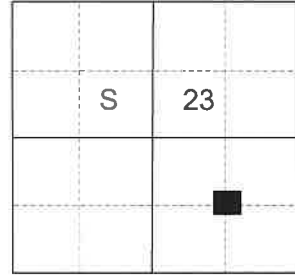

DESCRIPTION OF CORNER EVIDENCE FOUND:

None found.

Falls approx. 40 ft. Southwest of BLM approx. corner tag on fence post.

DESCRIPTION OF MONUMENT AND ACCESSORIES I ESTABLISHED TO MONUMENT THE ORIGINAL LOCATION OF THIS CORNER:

At position by Survey I set a 5/8" x 30" iron pin, 28" in the ground, with 2 1/2" aluminum cap marked as shown below, from which:

NEW BEARING OBJECTS:

A 12" White Fir bears South 25° East, a dist. of 5.10 ft., marked SE 1/16 S23 BT.

A 10" White Fir bears South 79° West, a dist. of 1.75 ft., marked SE 1/16 S23 BT.


Set steel fence post approx. 1 ft. East

I hereby certify that the corner was monumented on September 15, 2021.

Witness: Kyle A. Tucker, Emmitt Ambert



Renewal Date: June 30, 2023

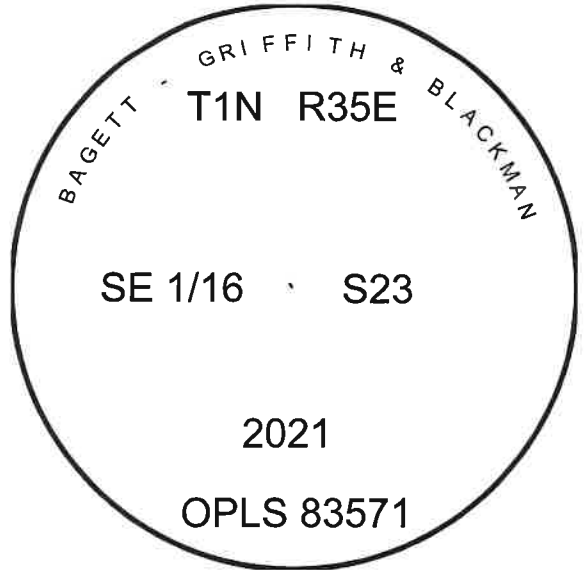

I used a steel tape and magnetic compass in the establishment of the new accessories. I used 14° East declination. Distances are to a 60d spike driven into the right side of the root crown of the bearing trees. Bearings are to a brass washer marked OPLS 83571 is attached to the BT blaze of the new bearing trees.