


CERTIFIED RECORD OF LAND CORNER MONUMENTATION

HISTORY OF ORIGINAL CORNER ESTABLISHMENT:
Corner not previously established.

T 1 N R 35 E R-14

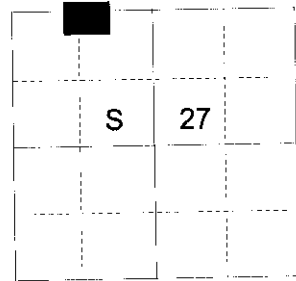

DESCRIPTION OF CORNER EVIDENCE FOUND:
None.

**DESCRIPTION OF MONUMENT AND ACCESSORIES I ESTABLISHED
TO PERPETUATE THE ORIGINAL LOCATION OF THIS CORNER:**

At position determined by survey, I set a 5/8" x 30" rebar with 2 1/2" aluminum cap, marked as shown below, 28 inches in the ground, in a collar of stone 1 ft. in diameter, from which:


An 8 inch White Fir bears North 72° East, a distance of 10.00 feet, marked W 1/16 S22 BT.
An 8 inch Lodgepole Pine bears South 26° East, a distance of 15.55 feet, marked W 1/16 S27 BT.

I set a steel fencepost approx. 1 foot East of corner monument.
I hereby certify that the corner was monumented on November 8, 2012.

Witness: Rick Robinson

REGISTERED
PROFESSIONAL
LAND SURVEYOR
[Signature]
OREGON
June 2, 2010
JEFFERY S. HSU
83571

Renewal Date: June 30, 2013

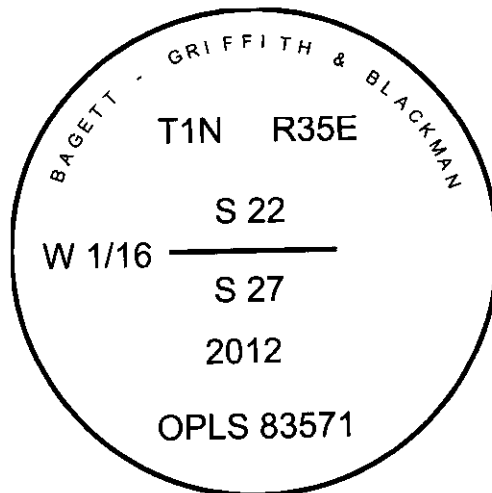

I used a steel tape and magnetic compass in the establishment of trees. I used 16° East magnetic declination. Distances are to a 60d spike in the right hand side of the new trees. Bearing is to a brass washer marked OPLS 83571 in the lower BT blaze.

RECEIVED BY
Umatilla County Surveyor
Date: 12/14/2012
Rec'd By: [Signature]
No.: 12-145-B

R-14