


CERTIFIED RECORD OF LAND CORNER MONUMENTATION

HISTORY OF ORIGINAL CORNER ESTABLISHMENT:

Corner originally established by Marius Buchanan under GLO Contract Number 635, dated April 19, 1895. Surveyor General record states:

T 1 N R 35 E R-21

Set a tamarac post 3 ft. long, 3 ins. square, 24 ins. in the ground for cors to Secs. 23, 24, 25 and 26, marked T1N S24 on NE, R35 S25 on SE, S26 on SW and S23 on NW faces, with 2 notches on S and 1 on E edges, from which:
A tamarac 14 ins. dia. bears N 60 1/2° E 52 lks. dist., marked T1N R35 E S24 BT.
A pine 16 ins. diam., bears S50E. 30 lks. dist., marked T1N R35 E S25 BT.
A fir 12 ins. diam. bears S46°W 51 1/2 lks. dist, marked T1N R35E S26 BT.
A fir 12 ins. diam. bears N46°W 22 lks. dist., marked T1N R35E S23 BT.

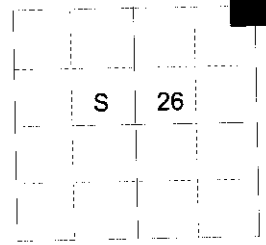

In Umatilla County monumentation record 83-194-R, Gary Langlitz monuments corner to County standard from found GLO bearing trees. Corner record states:

Found a Western larch stump, rotted at ground level, size indeterminate, no marking found (orig. NE bear tree)
A Ponderosa Pine stump, rotted at ground level, size indeterminate, no markings found (orig. SE bearing tree)
A Douglas Fir stump, rotted at ground level, size indeterminate, no markings found (orig. SW bearing tree)
A Douglas Fir stump, rotted at ground level, size indeterminate, with original blazed face lying alongside, scribing "R35E S23 BT" visible (orig NW bearing tree)
At the corner point determined in the following relationship to the found remains of the original BT's, we set a 2" x 30" galvanized iron pipe, 28" in the ground with brass cap attached, from which:
The original bearing trees as previously described:
A Western Larch stump bears N60 1/2°E, 34.3 ft. to apparent face.
A Ponderosa Pine stump bears S48°E 19.8 ft. to apparent face.
A Douglas Fir stump bears S43°W 34.0 ft. to apparent face.
A Douglas Fir stump bears N39°W 14.5 ft. to apparent face.
We mark new bearing trees:
A 12" Douglas Fir, scribed "T1N R35E S26 BT" on a double blaze bears S81°W 21.4 ft.
An 8" Grand Fir, scribed "T1N R35E S23 BT" on a double blaze bears N45°W 16.2 ft.
A 10" Western Larch, scribed "T1N R35E S24 BT" on a double blaze bears N66 1/2°E 38.3 ft.
A 10" Douglas Fir, scribed "T1N R35E S25 BT" on a double blaze bears S14E 57.1 ft.

DESCRIPTION OF CORNER EVIDENCE FOUND:

Found 2 1/2" iron pipe with 2 1/2" brass cap marked as shown below, 3 inches above ground. From which:
A 13 inch Western Larch bears North 64° East, a distance of 38.3 feet, dead, standing with healed blaze.
A 16 inch Douglas Fir bears South 84° West, a distance of 21.4 feet, alive and vigorous with healed blaze.
A 14 inch Grand Fir bears North 45° West, a distance of 16.2 feet, alive and vigorous with healed blaze.

DESCRIPTION OF MONUMENT AND ACCESSORIES I ESTABLISHED TO PERPETUATE THE ORIGINAL LOCATION OF THIS CORNER:

From the iron pipe monument, I take new bearing trees.


A 16 inch Douglas Fir bears North 78° East, a distance of 37.05 feet, marked T1N R35E S24 BT.
A 5 inch Ponderosa Pine bears South 28° East, a distance of 35.05 feet, marked X BT.

I hereby certify that the corner was perpetuated on November 6, 2012. Corner falls in a North/South running fence approximately 100 feet South of a draw.

Witness: Rick Robinson



Renewal Date: June 30, 2013

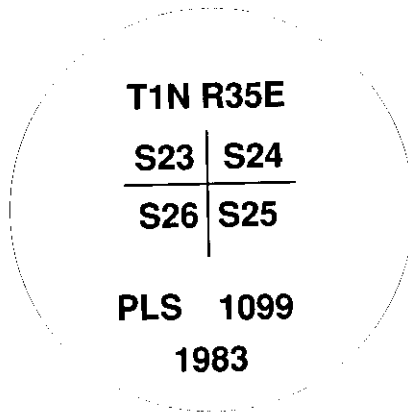

RECEIVED BY
Umatilla County Surveyor
Date: 12/14/2012
Rec'd By: J. Hsu
No.: 12-115-3
12-146-R

I used a steel tape and magnetic compass in the recovery of the bearing trees and establishment of new tree. I used 16° East magnetic declination and the bearings and distances are to the center of root crown on old bearing trees. Distance is to a 60d spike in the right hand side of the new trees. Bearing is to a brass washer marked OPLS 83571 in the lower BT blaze.