

CERTIFIED RECORD OF LAND CORNER MONUMENTATION

HISTORY OF ORIGINAL CORNER ESTABLISHMENT:


Corner originally established by Currin and Noland under GLO contract dated May 4, 1887. Surveyor General record states:

Set post 3 ft. long, 3 ins. square, 24 ins. in the ground for 1/4 Sec. Cor, marked 1/4 S on N face, from which:

- A tamarack 12 ins. diam., bears N60°W, 13 lks. dist., marked 1/4 S BT.
- A fir 12 ins. diam., bears S65°E, 27 lks. dist., marked 1/4 S BT.

In 1975, Chris T. Palmer determines corner position by found bearing trees in Survey filed as 03-274-C. No monument was set.

T 1 N R 35 E R-03

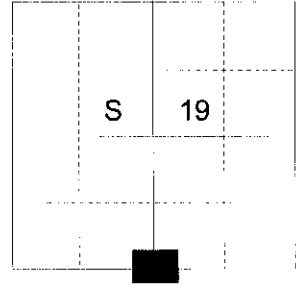

DESCRIPTION OF CORNER EVIDENCE FOUND:

No original evidence remains.

Based on a retracement of Survey 03-274-C, I use the found brass cap positions at the Southwest corner of Section 19 and the W 1/16th corner common to Sections 19 and 30 to establish a position where Palmer had placed the corner from found bearing trees. Six inches below existing grade, I find remnants of a wood lath, presumable set by Palmer, as it falls within a foot of the determined position. From this lath, a stump hole falls approximately at the position of the Northwest bearing tree. I accept the position of this wood lath as the best available evidence of the position of the original corner monument.

DESCRIPTION OF MONUMENT AND ACCESSORIES I ESTABLISHED

TO PERPETUATE THE ORIGINAL LOCATION OF THIS CORNER:

At the wood lath position, I set a 2 1/2" x 30" aluminum pipe with 2 1/2" aluminum cap marked as shown below, 29 inches in the ground, from which:


- A 15 inch White fir bears North 46° East, a distance of 13.85 feet, marked 1/4 S19 BT.
- A 12 inch Douglas Fir bears South 88° East, a distance of 24.25 feet, marked 1/4 S30 BT.
- A 15 inch White Fir bears South 75° West, a distance of 9.85 feet, marked 1/4 S30 BT.
- A 5 inch Ponderosa Pine bears North 40° West, a distance of 29.95 feet, marked X BT.

Set a steel fencepost 1 foot West of monument.

I hereby certify that the corner was perpetuated on August 22, 2013.
Witness: Rick G. Robinson



Renewal Date: June 30, 2015

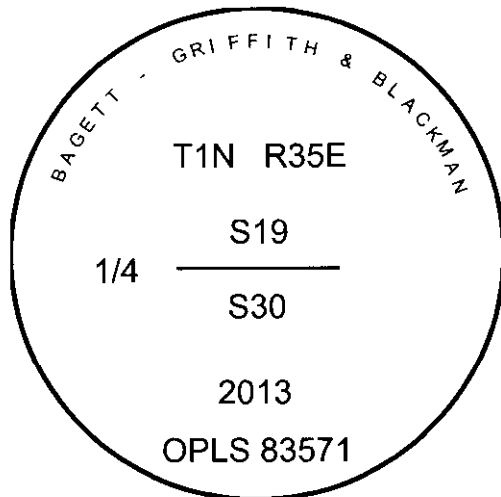

I used a steel tape and magnetic compass in the establishment of bearing trees. I used 16° East magnetic declination. Distances are to a 60d spike in the right hand side of the new trees. Bearings are to a brass washer marked OPLS 83571 in the lower BT blaze.

RECEIVED BY

Umatilla County Surveyor

Date: 9/20/2013

Rec'd By: *Jay Roberts*

No.: 13-521-B

R-03