


CERTIFIED RECORD OF LAND CORNER MONUMENTATION

HISTORY OF ORIGINAL CORNER ESTABLISHED:

Corner originally established Chris Palmer in Survey M-045-C (03-274-C). Survey indicates a brass cap was set.

T 1 N R 35 E W-03

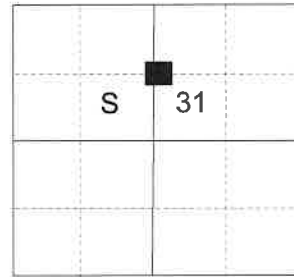

DESCRIPTION OF CORNER EVIDENCE FOUND:

Found 2" iron pipe with 2 1/2" brass cap, set by Palmer, removed from ground and lying horizontal, the original corner position could not be ascertained. I find bearing trees with healed blazes, but no associated monumentation record.

DESCRIPTION OF MONUMENT AND ACCESSORIES I ESTABLISHED TO MONUMENT THE ORIGINAL LOCATION OF THIS CORNER:


At position determined by survey, I set a 5/8" x 30" iron pin, 19" in the ground, with 2 1/2" aluminum cap, marked as shown below, in a 1 ft. collar of stone, from which:

NEW BEARING OBJECT:

A 22" Ponderosa Pine, bears North 73° East, a distance of 22.40, alive and vigorous with healed blaze.

A 12" Douglas Fir bears South 1° East, a distance of 34.75 feet, alive and vigorous with healed blaze.

I hereby certify that the corner was monumented on November 9, 2023

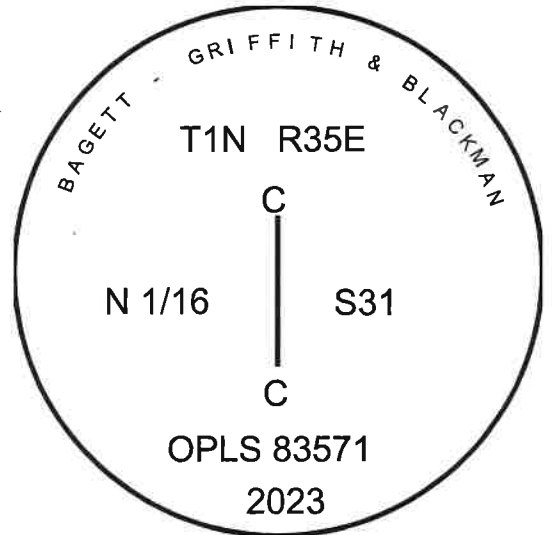

Renewal Date: June 30, 20235

I used a steel tape and magnetic compass in the establishment of the new accessories. I used 14° East declination, the distances are to the center of the root crown of the bearing trees.

W-03

23-104-C