

Index

File No. J-01

CORNER RECORD (SEARCH)

(Ref. FSM 7151.4)

Tract or Survey No. _____ Cor. No. _____

T IN R. 36E

R.D. WALLA WALLA County WATILLA

Merid. W.M.

N.F. WATILLA State OREGON

CORNER DIAGRAM



DESCRIBE CORNER MONUMENT FOUND

3/4" BLM BRASS CAP ON 2 1/2" IP RISING 4"

DESCRIBE BEARING TREES OR OTHER OFFICIAL ACCESSORIES FOUND

22" DOUG FIR BLAZED & SCRIBED TIN R36E S13BT
 BEARS S88 3/4° W ~ 220 LKS - 145 ± FT
 40" DEAD POND PINE 25' TALL B&S IN 35E S1A
 BEARS S28° W 197 LKS - 130 ± FT
 13" DOUG FIR B&S TIN R36E S13BT
 BEARS S25° E 304 LKS - 200 ± FT

PHOTO IDENTIFICATION DATA

Photo No. _____
 Filed At. _____
 Object Ident. _____
 Ident. By _____
 Signature _____

PLANE COORDINATE POSITION DATA

State _____ Zone _____
 X _____
 Y _____
 Estab. By _____
 Agency _____

DESCRIBE CORNER LOCATION RELATIVE TO NEAR-BY FEATURES, ALSO HOW TO REACH CORNER

FROM 3030 FOLLOW 3030 OLD N'LY 1/2 MILE RT ON UNMARKED RD TO OLD LANDING, FOLLOW RIDGE TO POSTED LINE WEST 250' TO 1/4 (3/18) NORTH ON POSTED LINE 1/2 MILE, TO CORNER CORNER IS ON SW'LY SLOPE 150' ABOVE LITTLE SQUAW CREEK

Signature B. Sutton

Title LS184B Division _____ Headquarters _____ Date 5-85 7100-52 (3. 68)

CORNER RECORD (PERPETUATION)

MONUMENT: DESCRIBE NEW MONUMENT SET, OR WORK DONE TO PRESERVE EXISTING MONUMENT

NONE

ACCESSORIES: DESCRIBE NEW BT'S WITNESS OBJECTS ETC. ESTABLISHED, OR WORK DONE TO PRESERVE EXISTING EVIDENCE

SET STEEL FENCE POST 25' So.
ATTACHED SIGNS TO POST & BT'S
PAINTED RED BANDS

Work Done By: B. SUTTON Title: SURVEYOR Date: 5-25 State Registration No. LS 1848
or Agency

Certified Cor. Record Prepared? Yes No Filed At: _____ Date _____

REMARKS

Index File No.

J-01

T. 18

R. 36E

M. W.M.

Tract or Surv. No.

Cor.

12/7
13/18

Index File No. J-25


CORNER RECORD (SEARCH)

(Ref. FSM 7151.4)

Tract or Survey No. _____ Cor. No. _____

T IN R. 35E R.D. _____ County _____ State _____
Merid. _____ N.F. _____

CORNER DIAGRAM

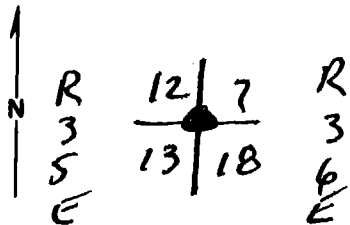

DESCRIBE CORNER MONUMENT FOUND

*Brass Cap set By BLM
1982*

DESCRIBE BEARING TREES OR OTHER OFFICIAL ACCESSORIES FOUND

PHOTO IDENTIFICATION DATA

Photo No. _____
Filed At. _____
Object Ident. _____
Ident. By _____
Signature

DESCRIBE CORNER LOCATION RELATIVE TO NEAR-BY FEATURES, ALSO HOW TO REACH CORNER

PLANE COORDINATE POSITION DATA

State _____ Zone _____
X _____
Y _____
Estab. By _____
Agency

Signature

Title

Division

Headquarters

Date

CORNER RECORD (PERPETUATION)

MONUMENT : DESCRIBE NEW MONUMENT SET, OR WORK DONE TO PRESERVE EXISTING MONUMENT

ACCESSORIES : DESCRIBE NEW BT'S WITNESS OBJECTS ETC. ESTABLISHED, OR WORK DONE TO PRESERVE EXISTING EVIDENCE

Work Done By _____ Title _____ Date _____ State Registration No. _____
or Agency _____

Certified Cor. Record Prepared ? Yes No Filed At: _____ Date _____

REMARKS

Index File No. T. R. M. Tract or Surv. No. Cor.

P

USDA-FOREST SERVICE

BLM

Index File No. J-25


CORNER RECORD (SEARCH)
(Ref. FSM 7151.4)

Tract or Survey No. _____ Cor. No. J-25

T 1N R. 35E R.D. _____ County _____

Merid. _____ N.F. _____ State _____

CORNER DIAGRAM

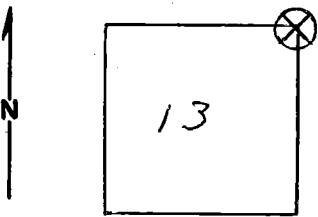

DESCRIBE CORNER MONUMENT FOUND

No monument found,

DESCRIBE BEARING TREES OR OTHER OFFICIAL ACCESSORIES FOUND

36" Pina stub. bears S28E 197 KFS.
This B.T. is just at the edge of the timber above a little square creek.
Other B.T. not found.

PHOTO IDENTIFICATION DATA

Photo No. _____
Filed At. _____
Object Ident. _____
Ident. By _____

Signature

PLANE COORDINATE POSITION DATA

State _____ Zone _____
X _____
Y _____
Estab. By _____

Agency

DESCRIBE CORNER LOCATION RELATIVE TO NEAR-BY FEATURES, ALSO HOW TO REACH CORNER

Corner is approx. 6 chains above Little Square creek on bare steep slope. A large rock out-cropping sits above the corner.

Signature Hullis Christy Title Ranger - Forestry Division _____ Headquarters Bullter, Oras Date 8-18-71 7100-52-(3/68) 1

4

5

CORNER RECORD (PERPETUATION)

MONUMENT: DESCRIBE NEW MONUMENT SET, OR WORK DONE TO PRESERVE EXISTING MONUMENT

Set short steel post with iron nails location tag and boundary tag. Reused mound of rock around post. Established from B.T.s

ACCESSORIES : DESCRIBE NEW B.T.'s WITNESS OBJECTS ETC. ESTABLISHED, OR WORK DONE TO PRESERVE EXISTING EVIDENCE

Work Done By _____ Title _____ Date _____ State Registration No. or Agency _____
Certified Cor. Record Prepared? Yes No Filed At: _____ Date _____

REMARKS

Index File No. T. R. M. Tract or Surv. No. Cor. U.S. G.P.O. 1977-725-576/586