

USDA-FOREST SERVICE

Index File No. R-5

CORNER RECORD (SEARCH)

(Ref. FSM 7151.4)

Tract or Survey No. _____ Cor. No. _____


T 1N R. 37E

R.D. Walla Walla County Umatilla

Merid. _____

N.F. Umatilla State OR

CORNER DIAGRAM

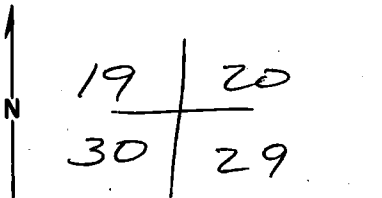

DESCRIBE CORNER MONUMENT FOUND

Found the Northeast bearing tree

DESCRIBE BEARING TREES OR OTHER OFFICIAL ACCESSORIES FOUND

26" Douglas fir w/ healed face.

PHOTO IDENTIFICATION DATA

Photo No. _____
Filed At. _____
Object Ident. _____
Ident. By _____
Signature

DESCRIBE CORNER LOCATION RELATIVE TO NEAR-BY FEATURES, ALSO HOW TO REACH CORNER

Follow K-TAG, ON FOOT TRAIL
(52 CARD BY GAYLORD)

PLANE COORDINATE POSITION DATA

State _____ Zone _____
X _____
Y _____
Estab. By _____
Agency

Signature

P.L.S.

Division

Headquarters

Date

10/93

FS-7100-52 (3/68)

USDA-FOREST SERVICE

Index
File No. R-5

CORNER RECORD (SEARCH)

(Ref. FSM 7151.4)

Tract or
Survey No. _____
Cor.
No. _____


T 1N R. 37E

R.D. WALLA WALLA County UMATILLA

Merid. WILLAMETTE

N.F. UMATILLA State OREGON

CORNER DIAGRAM

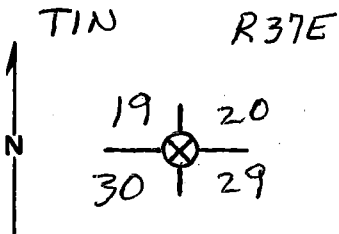

DESCRIBE CORNER MONUMENT FOUND

NONE

DESCRIBE BEARING TREES OR OTHER OFFICIAL ACCESSORIES FOUND 2

ORIG. 18" FIR IS LIVE. HAS HEALED LOWER BLAZE & POSSIBLE BARK SCRIBES ON UPPER PART OF TREE. BEARS N 40° E, 117 LINKS.

ORIG. 20" FIR IS DOWN & BADLY DECAYED. I COULD FIND NO MARKS.

OTHER 2 BT'S GONE.

DESCRIBE CORNER LOCATION RELATIVE TO NEAR-BY FEATURES, ALSO HOW TO REACH CORNER 3

PLACED LOCATION POSTER ON 48" FIR ON EDGE OF OPENING NORTH OF CREEK. BT BEARS ~~NEED~~ S 77° E, ABOUT 500 FEET.

PHOTO IDENTIFICATION DATA

Photo No. _____

Filed At. _____

Object Ident. _____

Ident. By _____

Signature

PLANE COORDINATE POSITION DATA

State _____ Zone _____

X _____

Y _____

Estab. By _____

Agency

Signature

Title

Division

Headquarters

Date

FS-7100-52 (3/68)

Dennis A. Gaylord PLS 1636

S.O.

AUG 5, 1992

4

5

CORNER RECORD (PERPETUATION)

MONUMENT: DESCRIBE NEW MONUMENT SET, OR WORK DONE TO PRESERVE EXISTING MONUMENT

9

ACCESSORIES : DESCRIBE NEW BT'S WITNESS OBJECTS ETC. ESTABLISHED, OR WORK DONE TO PRESERVE EXISTING EVIDENCE

10

Work Done By _____ Title _____ Date _____ State Registration No. or Agency _____

Certified Cor. Record Prepared ? Yes No Filed At: _____ Date _____

11

REMARKS

12

Index File No. T. R. M. Tract or Surv. No. Cor. 13

CORNER RECORD (PERPETUATION)

MONUMENT: DESCRIBE NEW MONUMENT SET, OR WORK DONE TO PRESERVE EXISTING MONUMENT

At record bearing and distance from existing tree set a 3/4" aluminum cap on 2 1/2" x 30" aluminum pipe, 26" in ground.

T1NR37E
S19 / S20
S30 / S29
PLS 2535
1993

ACCESSORIES: DESCRIBE NEW BT'S WITNESS OBJECTS ETC. ESTABLISHED, OR WORK DONE TO PRESERVE EXISTING EVIDENCE

15" Douglas Fir, S. 17 1/2° E., 13.7 Feet scribed T1N37E S29BT

6" Douglas Fir, S. 45 1/2° W., 13.9 Feet scribed XBT

15" Douglas Fir, N. 49° W., 13.8 feet scribed T1NR37E S19BT.

1 1/2" Aluminum cap (PLS 2535) on 5/8" x 24" rebar, S. 55° W., 8.6 feet

Work Done By LeJeune Title P.L.S. Date 9/93 State Registration No. or Agency 2535

Certified Cor. Record Prepared Yes No Filed At: _____ Date _____

REMARKS

Index File No. R-5 T. 1N. R. 37E. M. W.M. Tract or Surv. No. _____ Cor. _____