


CERTIFIED RECORD OF LAND CORNER MONUMENTATION

A - 9
DIAGRAM

History of original corner establishment:

The original corner was established by George S. Pershin, deputy, (compassman) on October 24, 1871, under joint GLO contract No. 154, as follows:

Set a stone, 24" x 7" x 5", on southeast hillside for section corner to sections 4, 5, 32 and 33, T. 1 & 2 S., R. 30 E.

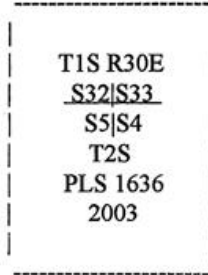

Original corner evidence recovered:

Found the original corner stone loosely set in a mound of stones. The corner stone is 25" x 11" x 9" and is plainly marked with four notches on the east edge and two notches on the west edge.

Monument and accessories established to perpetuate the original position of this corner:

In place of the original corner stone, I set a 1" x 18" flared, galvanized iron pipe 8" into the ground to bedrock. A 2 1/2" brass cap attached to the top of the pipe is marked as shown in the diagram above. I placed the corner stone horizontally along the north side of the pipe and build a mound of stones around the corner stone and pipe, from which:

A 5/8" x 24" iron rod set 21" into the ground with a 3/4" brass washer, marked "PLS 1636 33", attached at ground level, bears N45° 30' E, 71.7 feet.

A 5/8" x 24" iron rod set 23" into the ground with a 3/4" brass washer, marked "PLS 1636 S4", attached at ground level, bears S23° E, 58.4 feet.

A 5/8" x 24" iron rod set 22" into the ground with a 3/4" brass washer, marked "PLS 1636 S5", attached at ground level, bears S69° W, 65.1 feet.


A 5/8" x 24" iron rod set 23" into the ground with a 3/4" brass washer, marked "PLS 1636 32", attached at ground level, bears N16° W, 141.5 feet.

I nail a "witness post" sign to a wooden fence post 0.5 feet south of the corner.

I hereby certify this corner point was perpetuated as hereon described on February 22, 2003.

Magnetic declination set in compass: 18° E.

NAD '83 UTM Zone 11 position: 5032798N 335386E (plus or minus two meters)

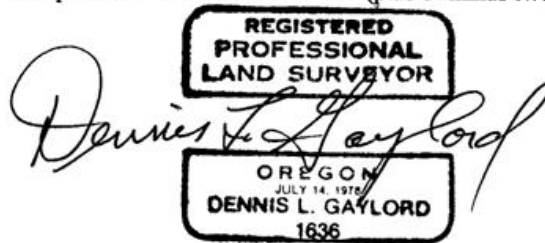

Renews June 30, 2003

Recorded at the office of County Surveyor, County of Umatilla, State of Oregon, on:

RECEIVED BY
 Umatilla County Surveyor
 Date 5-03
 Rec'd By KK
 No. 03-67-R