

OREGON CORNER RESTORATION FORM

CORNER DESIGNATION: T1S, R30-1/2E, T-21

WEST QUARTER CORNER OF SECTION 25, TOWNSHIP 1 SOUTH, RANGE 30-1/2 EAST, W.M., UMATILLA COUNTY, OREGON.

PREVIOUS RENEWALS / SURVEYS, ETC.:

T1S R30-1/2E WAS ORIGINALLY SUBDIVIDED BY U.S. DEPUTY SURVEYOR GEORGE S. PERSHIN UNDER CONTRACT NO. 410 DATED JULY 28, 1881. THE NOTES READ, "SET BASALT STONE 16X8X7 INCHES, 10 INS IN GROUND MARKED 1/4 ON WEST FACE FOR 1/4 SEC. COR. ON LEVEL RAISED MOUND OF STONE ALONG SIDE IN LIEU OF PITS."

MONUMENT AND ACCESSORIES FOUND:

FOUND BASALT STONE 17X8X6, CLEARLY MARKED WITH 1/4. STONE WAS RECESSED IN A FEW INCHES OF SOIL AND LYING ON ITS SIDE WITH SCATTERED STONE MOUND IMMEDIATELY TO THE SOUTHWEST. EXISTING EAST-WEST BARBED WIRE FENCE IS APPROXIMATELY 7 FEET NORTH OF FOUND CORNER STONE.


MONUMENT AND ACCESSORIES SET:

AT FOUND STONE LOCATION, SET 2-1/2 INCH BRASS CAP ON 1" (I.D.) X 30" GALVANIZED IRON PIPE, 13" ABOVE GRADE, MARKED AS SHOWN IN DETAIL BELOW. REINFORCED EXPOSED PIPE WITH STONE MOUND AND SOIL TO CAP. SET 4 REFERENCE MONUMENTS AS DESCRIBED AND DETAILED BELOW. BURIED CORNER STONE IN MOUND ON SOUTH SIDE OF THE BRASS CAP. BEARINGS WERE TAKEN WITH HANDHELD COMPASS; DISTANCES WERE MEASURED WITH FIBERGLASS TAPE MEASURE.


REFERENCES:

- (A) SET 5/8" X 30" STEEL REBAR MARKED "UCPWD LS89374" BEARING OBJECT SIGN ATTACHED TO REBAR. CORNER BEARS S 86° E, 52.5'.
- (B) SET 5/8" X 30" STEEL REBAR MARKED "UCPWD LS89374" BEARING OBJECT SIGN ATTACHED TO REBAR. CORNER BEARS S 87° W, 46'.
- (C) SET 5/8" X 30" STEEL REBAR MARKED "UCPWD LS89374" BEARING OBJECT SIGN ATTACHED TO REBAR. CORNER BEARS N 36° W, 70'.
- (D) SET 5/8" X 30" STEEL REBAR MARKED "UCPWD LS89374" BEARING OBJECT SIGN ATTACHED TO REBAR. CORNER BEARS N 37° E, 172.5'.

DIAGRAM:

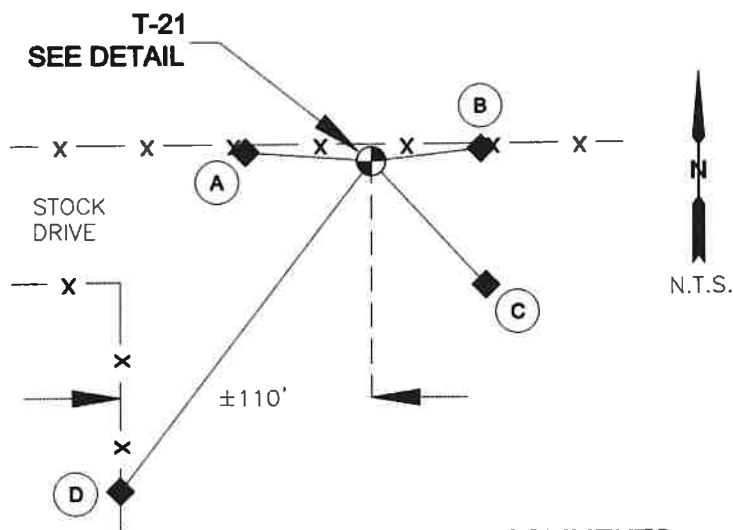

T-21 DETAIL:

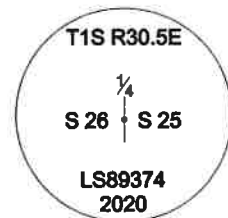

COORDINATES:

NAD 83/11 OREGON NORTH STATE
 PLANE COORDINATE VALUES
 N:653,942.49 E:8,582,339.28
 LATITUDE: 45°27'02.94876"
 LONGITUDE: 119°01'05.56954"

LOCATION AND COMMENTS:

CORNER IS LOCATED APPROXIMATELY 1.03 MILES SOUTH OF HIGHWAY 74 AND ALKALI CANYON ROAD, 650 FEET EAST OF THE CENTER OF A NORTH-EAST STOCK DRIVE / ROAD.

FIRM/AGENCY:

UMATILLA COUNTY PUBLIC WORKS DEPARTMENT
 3920 WESTGATE, PENDLETON, OREGON 97801
PARTY CHIEF: MATT KENNY
WITNESS: TROY ALDERSON

BEARING BASE:

REPORTED BEARINGS ARE HANDHELD COMPASS BEARINGS TAKEN TO THE NEAREST DEGREE DECLINATION = 14° E

**REGISTERED
 PROFESSIONAL
 LAND SURVEYOR**

Matt Kenny
 OREGON
 JAN 12, 2016
 MATTHEW PATRICK KENNY
 89374PLS

RENEWALS: 6-30-21