

**OREGON CORNER RESTORATION FORM**

Section 3 Township 1S Range 31E  
 County Umatilla Date: October 4, 2001

Corner Designation: 1S31A13



North section corner to sections 3 and 4, T1S, R31E,  
 W.M., Umatilla County, Oregon.

Condition Report Only  
 Not found  
 Remonumented  
 Unrecorded  
 Surveyed in  
 Referenced out

Previous Renewals / Surveys, etc.

The corner was originally set by David P. Thompson under contract No. 106 dated August 16, 1864. His record reads: Set stone 17 x 14 x 8 in. for corner to secs. 3 & 4. The County Surveyor, Aubrey Perry, records "rock 17" x 14" x 8" " in the survey recorded in Book 2 at page 301 of the Record of Private Surveys.

Monument and Accessories found: ( condition and source )  
 None: The corner falls in a plowed field.

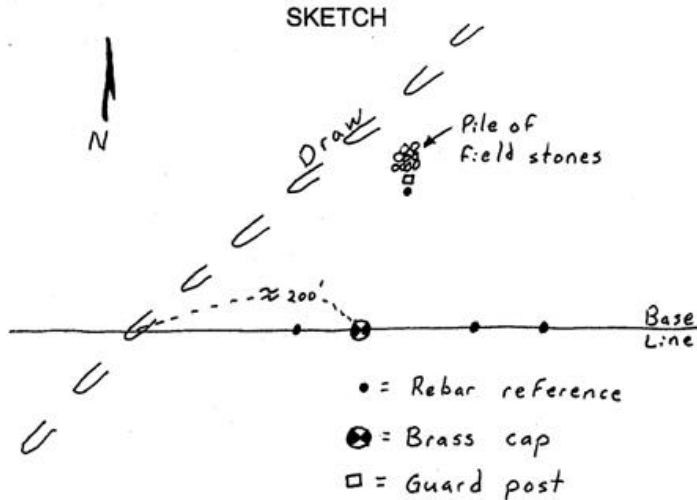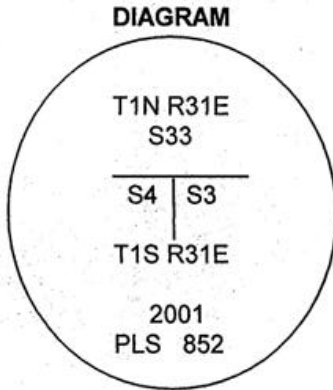

**MONUMENT (S) AND ACCESSORIES SET (Procedures and Description)**

At the proportionate point I set a 6" x 1 1/8" G.I.P. with a 2 1/2" brass stamped as shown in the diagram above. The cap is cemented to a 12" x 5/8" iron rebar which is cemented in a drill hole in the bed rock. The cap is 22" below the surface.

For references, I set four 5/8" by 24" rebars with 1 1/4" red plastic caps stamped ORLS 852, and WAL5: 13922 as described below:

- an iron rebar bears N13°51'41"E, 221.40 feet, near a pile of field stones. I set a 5' steel guard post near this reference with a bearing object sign attached.
- an iron rebar bears S87°16'26"E, 27.19 feet, 18" below the surface;
- an iron rebar bears S86°46'58"E, 50.46 feet, 18" below the surface;
- an iron rebar bears S89°40'46"W, 25.08 feet, 18" below the surface;

The monument and references were tied using a LIECA SYSTEM 300 RTK GPS.

Location and comments  
 OR SPC Oregon North 1983-91  
 N = 677957.58  
 E = 8603098.22

Compass Declination

Surveyors Seal

RECEIVED BY:  
Umatilla County Surveyor  
 Date: 12/20/2001  
 Rec'd By: DHL  
 No. 01-206-C

Firm / Agency  
 Haddock Surveying  
 Address  
 P.O. Box 1574  
 Pendleton, Or. 97801  
 Party Chief  
 Stephen K, Haddock



RENEWS 6-30-03