

OREGON CORNER RESTORATION FORM

Section 5 Township 1S Range 31E
 County Umatilla Date: October 4, 2001

Corner Designation: 1S31A7

North 1/4 section corner to section 5, T1S, R31E,
 W.M., Umatilla County, Oregon.

Condition Report Only
 Not found
 Remonumented
 Unrecorded
 Surveyed in
x Referenced out


Previous Renewals / Surveys, etc.

The corner was originally set by David P. Thompson under contract No. 106 dated August 16, 1864. His record reads: Set stone 16 x 8 x 5 ins. for 1/4 sec. closing corner. The County Surveyor, Aubrey Perry, in the survey recorded in Book 2, Page 301 of the Record of Private Surveys records: "Set rock on line of 1/4 cor. to Sec. 5 M 1/4.". Donald Staebler, Engineer 5408, in Count Survey H-7-B records "Found stone for 1/4 Sec. closing corner as per notes. Set Brass Cap."


Monument and Accessories found: (condition and source)

The 2" brass cap set by Staebler firmly in place with a steel guard post with a County monument sign attached.

DIAGRAM

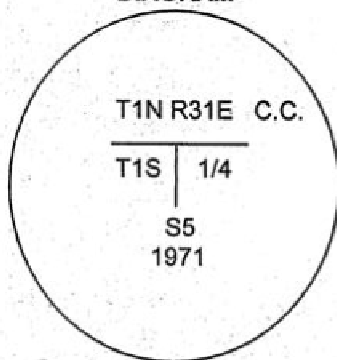

SKETCH

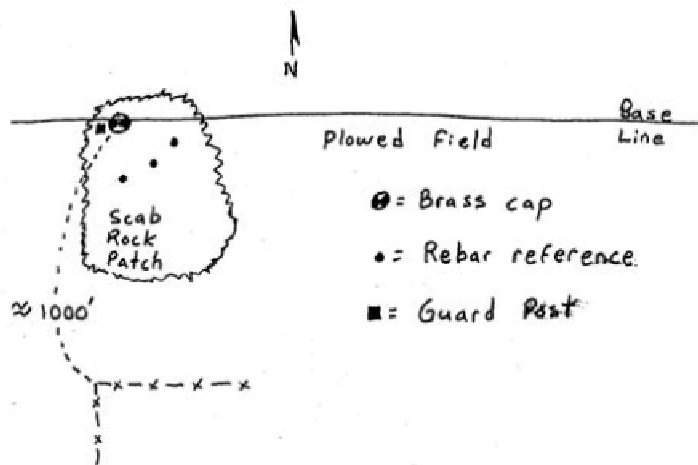

MONUMENT (S) AND ACCESSORIES SET (Procedures and Description)

For references, I set three 5/8" by 24" rebars with 1 1/4" red plastic caps stamped ORLS 852, and WAL5 13922 as described below:

- an iron rebar bears S62°12'41"E, 69.63 feet;
- an iron rebar bears S25°43'35"E, 57.12 feet;
- an iron rebar bears S30°19'24"E, 73.45 feet;

The monument and references were tied using a LIECA SYSTEM 300 RTK GPS.

Location and comments
 OR SPC Oregon North 1983-91
 N = 677857.42
 E = 8595166.11

Compass Declination

Surveyors Seal

RECEIVED BY:
 Umatilla County Surveyor
 Date: 12/30/2001
 Rec'd By: DHE
 No. 01-206-C

Firm / Agency
 Haddock Surveying
 Address
 P.O. Box 1574
 Pendleton, Or. 97801
 Party Chief
 Stephen K, Haddock

REGISTERED
 PROFESSIONAL
 LAND SURVEYOR

David L. Haddock

OREGON
 JULY 12, 1906
 DAVID L. HADDOCK
 852

RENEWS 6-30-03