

OREGON CORNER RESTORATION FORM

Section 34 Township 1S Range 31E
 County Umatilla Date: April 5, 2011

Corner Designation: 1S31V13

Corner to sections 27, 28, 33, and 34, T1S, R31E,
 W.M., Umatilla County, Oregon.

Condition Report Only

Not found

Remonumented

Unrecorded

Surveyed in

Referenced out


Previous Renewals / Surveys, etc.

Corner originally set by Daniel Chaplin under contract No. 107 dated September 21, 1864. His record reads: Set stone 20x16x16 for Cor. to Secs. 27, 28, 33 & 34. John Kimbrell in the survey in the record of private surveys Book 2, Page 223 says "the corner to secs. 27-28-33 & 34".

Monument and Accessories found: (condition and source)


I found a basalt stone 25x8x5 in a stone mound 6 feet in diameter and 1 foot high. I assume the stone was set by John Kimbrell since it is different than the one described by Chaplin.

DIAGRAM

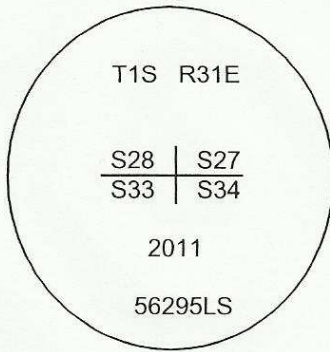

- ⊗ = Brass Cap
- = Rebar reference set 12" below the surface.

SKETCH

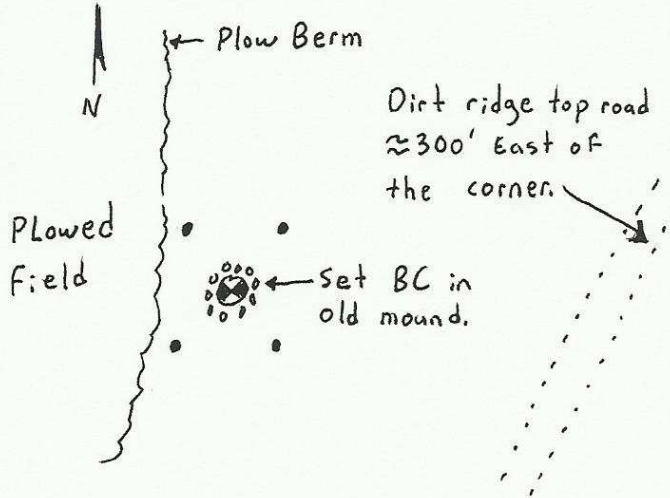

MONUMENT (S) AND ACCESSORIES SET (Procedures and Description)

At the position of the found stone I set a 1 1/2" x 30" galvanized iron pipe with a 2 1/4" brass cap stamped as shown in the diagram above.

For references, I set four, 5/8" by 24" rebars with 1 1/8" orange plastic caps attached, stamped WTS and 56295LS as described below:

- an iron rebar bears N43°54'26"W, 30.83 feet;
- an iron rebar bears N50°31'42"E, 37.67 feet;
- an iron rebar bears S51°42'35"E, 30.43 feet;
- an iron rebar bears S35°58'36"W, 34.51 feet;

The monument and references were tied using a Trimble R7/R8 RTK GPS.

Location and comments

Compass Declination

Surveyors Seal

RECEIVED BY:
 Umatilla County Surveyor
 Date: _____
 Rec'd By: _____
 No. 11-112-C

Firm / Agency
 Witness Tree Surveying
 Address
 P.O. Box G
 Pilot Rock, Or. 97868
 Party Chief
 Stephen K, Haddock

REGISTERED
 PROFESSIONAL
 LAND SURVEYOR

Stephen K. Haddock

OREGON
 JULY 9, 2001
 STEPHEN K. HADDOCK
 56295LS

RENEWAL DATE 6-30-13