


CERTIFIED RECORD OF LAND CORNER MONUMENTATION

North quarter corner to Section 4, T1S, R32E, W M.

Index: 1S 32 A-11

DIAGRAM

History of original corner establishment:  
Corner originally set by Thompson in contract 106 dated 1864. His record reads: 40.00 Set post for 1/4 sec. closing corner in mound of earth with charred stake, pits, trench &c as per instructions.

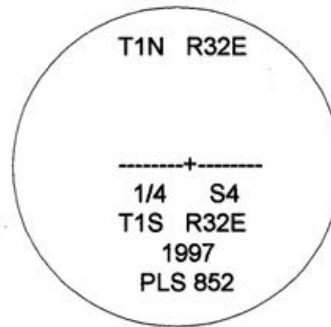

Evidence Found: None

Description of monument and accessories I established to perpetuate the original location of this corner:

At the point proportioned between the found original south quarter corner of Section 33, T1N, R32E, and the stone set by survey recorded in Record of Private Surveys, book 2 page 299, for the corner to Sections 32 and 33, T1N, R32E,

I set a 1.25" x 30" galvanized iron pipe with a 2.25" brass cap, stamped as shown in the diagram, 24" below the surface 1.7 feet north of an existing east - west fence.

I set four 5/8" by 24" rebars with 1.25" red plastic caps stamped ORLS 852 and WALS 13922 as described below:

- a rebar bears S88°27'E, 99.52 feet under the east - west fence;
- a rebar bears S87°23'E, 55.49 feet under the east - west fence;
- a rebar bears S88°05'W, 49.66 feet under the east - west fence;
- a rebar bears S89°25'W, 102.46 feet under the east - west fence;

The bearings are true.

This work was done June 16, 1997, and witnessed by Stephen K. Haddock.

Office of \_\_\_\_\_, I hereby certify that the within instrument was filed  
State of \_\_\_\_\_  
in this office for record on the \_\_\_\_\_ day of \_\_\_\_\_ by \_\_\_\_\_  
\_\_\_\_\_ ( COUNTY OFFICIAL ) ( DEPUTY )

County of Umatilla

REGISTERED  
PROFESSIONAL  
LAND SURVEYOR

*David L. Haddock*

OREGON  
JULY 12, 1909  
DAVID L. HADDOCK  
852

RECEIVED BY  
Umatilla County Surveyor  
Date 7-97  
Rec'd By KK  
No. 97-140-C