


CERTIFIED RECORD OF LAND CORNER MONUMENTATION

Corner to Sections 1, T1S, R32E, and Section 6, T1S, R33E.

Index: 1S 32 A-25

DIAGRAM

History of original corner establishment:  
Corner originally set by Thompson in contract 106 dated 1864. His record reads: 81.00 Intersect Base Line, 18.00 chs. W. of Tp. Standard Cor. & build mound of stone.

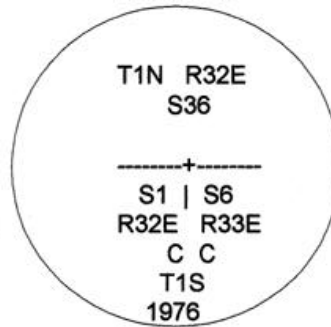

BLM Group 921, under instructions dated October 28, 1976, re-set this corner. His record reads: Point for the closing cor. of Tps. 1 S., Rs. 32 and 33 E., at proportionate dist.; there is no remaining evidence of the original cor. or of the witness cor. set by Wilkes in 1917.

Set an iron post, 28 ins. long, 2 1/2 ins. diam., 12 ins. in the ground, to bedrock, supported in a mound of stone, 3 ft. base, to top with brass cap, marked ( see diagram ).

Evidence Found: Found the brass cap described above in good condition in a stone mound 1' north of an east - west fence in bottom of a shallow draw.

Description of monument and accessories I established to perpetuate the original location of this corner:

I set four 5/8" by 24" rebars with 1.25" red plastic caps stamped ORLS 852 and WALS 13922 as described below:

- a rebar bears S88°21'E, 93.20 feet under the east bound fence;
- a rebar bears S87°24'E, 47.78 feet under the east bound fence;
- a rebar bears S89°11'W, 58.01 feet under the west bound fence;
- a rebar bears S89°33'W, 118.60 feet under the west bound fence;

The bearings are true.

This work was done June 10, 1997, and witnessed by Stephen K. Haddock,

County of Umatilla

Office of \_\_\_\_\_, I hereby certify that the within instrument was filed  
State of \_\_\_\_\_

in this office for record on the \_\_\_\_\_ day of \_\_\_\_\_ by \_\_\_\_\_  
( COUNTY OFFICIAL ) ( DEPUTY )

RECEIVED BY  
Umatilla County Surveyor  
Date 7-97  
Rec'd By KK  
No. 97-140-C

REGISTERED  
PROFESSIONAL  
LAND SURVEYOR

*David L. Haddock*

OREGON  
JULY 18, 1908  
DAVID L. HADDOCK  
652