


CERTIFIED RECORD OF LAND CORNER MONUMENTATION

Corner to Sections 5 and 6, T1S, R32E, W M.

Index: 1S 32 A-5

History of original corner establishment:
Corner originally set by Thompson in contract 106 dated 1864. His record reads: 79.60 Set post for corner to secs. 5 and 6 in mound of earth with charred stake, pits, trench & c as per instructions.

Evidence Found: None

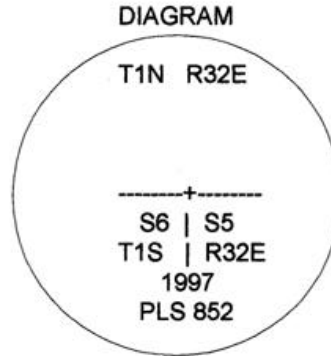

Description of monument and accessories I established to perpetuate the original location of this corner:

At the point proportioned between the corner of T1N, R31E and 32E, and the found stone, set by survey recorded in Record of Private Surveys, book 2, page 299, for the corner to Sections 32 and 33, T1N., R32E,

I set a 1.25" x 12" galvanized iron pipe with a 2.25" brass cap, stamped as shown in the diagram, 20" below the surface in a wheat field. The monument is cemented into a hole chiseled into rock.

I set four 5/8" by 24" rebars with 1.25" red plastic caps stamped ORLS 852 and WALS 13922 as described below:

- a rebar bears N88°03'W, 46.45 feet 20" below the surface.
- a rebar bears S8°43'E, 46.74 feet 20" below the surface;
- a rebar bears N00°28'E, 33.90 feet 20" below the surface;
- a rebar bears S87°51'E, 92.11 feet 20" below the surface;

The bearings are true.

This work was done June 17, 1997, and witnessed by Stephen K. Haddock.

Office of _____, I hereby certify that the within instrument was filed
 State of _____
 in this office for record on the _____ day of _____ by _____
 _____ (COUNTY OFFICIAL) (DEPUTY)

REGISTERED
PROFESSIONAL
LAND SURVEYOR

David L. Haddock

OREGON
JULY 12, 1999
DAVID L. HADDOCK
852

RECEIVED BY
Umatilla County Surveyor
Date 7-97
Rec'd By KK
No. 97-140-C