


CERTIFIED RECORD OF LAND CORNER MONUMENTATION

Corner to Sections 4 and 5, T1S, R32E, W M.

Index: 1S 32 A-9

DIAGRAM

History of original corner establishment:
Corner originally set by Thompson in contract 106 dated 1864. His record reads: 80.00 Set post for corner to secs. 4 and 5 in mound of earth with charred stake, pits, trench &c as per instructions.

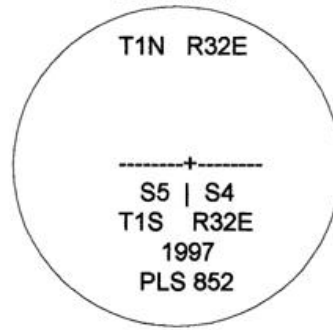

Evidence Found: None
A 3" pipe set by PLS 1333 in survey I-44-B bears N88°16'E, 93.53 feet.

Description of monument and accessories I established to perpetuate the original location of this corner:

At the point proportioned between the corner of T1N, R31E and 32E, and the found stone, set by survey recorded in Record of Surveys, book 2, page 299, for the corner to Sections 32 and 33, T1N, R32E,

I set a 1.25" x 30" galvanized iron pipe with a 2.25" brass cap, stamped as shown in the diagram, 1" below the surface in the top of a dike. The monument is 96 feet west of a fence intersection in the north edge of a dike for an industrial sediment pond and 5' south of the existing east - west fence.

I set two 5/8" by 24" rebars with 1.25" red plastic caps stamped ORLS 852 and WALS 13922 as described below:

a rebar bears N85°08'E, 57.02 feet under an east bound fence;

a rebar bears N78°41'W, 26.56 feet under a west bound fence;

I set two 1.25" brass washers stamped ORLS 852 and WALS 13922 as described below:

a washer bears S02°02'W, 78.40 feet nailed in the top of a test well guard pipe;

a washer bears S87°54E, 92.83 feet nailed in the top of a railroad tie fence post.

The bearings are true.

This work was done June 14, 1997, and witnessed by Stephen K. Haddock.

County of Umatilla
Office of _____, I hereby certify that the within instrument was filed
State of _____
in this office for record on the _____ day of _____ by _____
(COUNTY OFFICIAL) (DEPUTY)

RECEIVED BY
Umatilla County Surveyor
Date 7-97
Rec'd By SK
No. 97-140-C

REGISTERED
PROFESSIONAL
LAND SURVEYOR

David L. Haddock

OREGON
JULY 12, 1998
DAVID L. HADDOCK
852