

OREGON CORNER RESTORATION FORM

Section 1 Township 1S Range 32E

Σ-21

County Umatilla Date 7/13/87

CORNER DESIGNATION


- Condition Report Only
- Not Found
- Renewed
- Unrecorded
- Surveyed In
- Referenced Out

Previous Renewals/Surveys, etc. Originally a post with pits, (Chaplin-1864). Later a 12 by 9 by 7" basalt stone with notches as per instructions, (Currin and Noland-1884).


Monument(s) & Accessories Found: (Condition and Source)

North-South fence line and mound of rock from rock crib which exists from the remains of an east-west fence. According to Joe Miller, property owner, the east-west fence existed for many years before he removed it. Corner area is completely surrounded by wheat fields. Bearing and distance to monumented SE corner of Section 1 checks within reason. I accept the corner of the north-south fence and remains of the fence from the east as the best remaining evidence of the original corner location.

Monument Detail

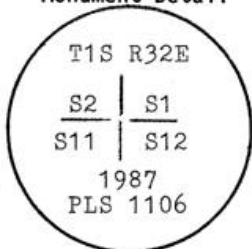

Sketch

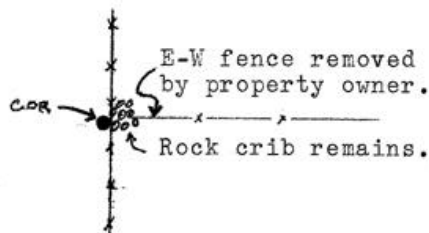

Monument Set (Procedures and Description)

Set 1" I.D. by 30" long G.I.P. w/ flared leg and 2 1/2" brass cap 22" in the ground and surrounded with a mound of stone.

New Accessories

A reference monument bears S3°E-9.1 feet.
A reference monument bears N3°W-11.5 feet.
Reference monuments are 5/8" by 30" rebar with 1 1/2" alum. caps marked "RM" with the distance to the corner. Set steel fence posts near each RM with bearing object and cor. signs attached.

Location & Comments

Cor. is located in a wheat field, 1/4 mile west of a field road.
 Compass Declination 19°
 Firm/Agency Bill Wells
 Land Surveyor.
 Address P.O. Box 1696 Pendleton, OR 97801
 Party Chief Bill Wells
 Notes
 Witness Bill Blanford

Surveyor's Seal

REGISTERED
PROFESSIONAL
LAND SURVEYOR

William R. Wells

OREGON
JULY 22, 1977
WILLIAM R. WELLS
1106

*Attachment
87-38-B*