

OREGON CORNER RESTORATION FORM

Section 14 Township 1S Range 32E
 County Umatilla Date: September 14, 2007

Corner Designation: 1S32N21


Condition Report Only
 Not found
 Remonumented
 Unrecorded
 Surveyed in
 Referenced out

Corner to sections 13, 14, 23, and 24, T1S, R32E,
 W.M., Umatilla County, Oregon.

Previous Renewals / Surveys, etc.

Corner originally set by Daniel Chaplin under contract No. 107 dated September 21, 1864. His record reads: Set post for Cor. to Secs. 13, 14, 23 & 24, in mound of earth, with charred stake, pits, etc., as per instructions. James Currin and James Noland, under special instructions dated May 4, 1887 report: found pits and mound.

Monument and Accessories found: (condition and source)
 A north - south fence line indicating the section line to the south.

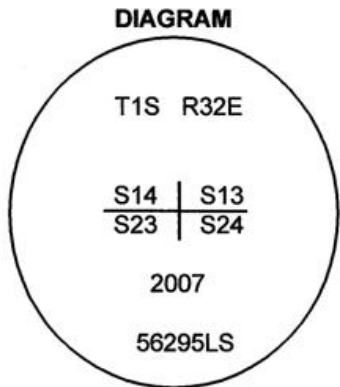

MONUMENT (S) AND ACCESSORIES SET (Procedures and Description)

I set a 1 1/2" x 30" galvanized iron pipe with a 2 1/4" brass cap stamped as shown in the diagram above at the intersection of the north - south fence at proportional distances from the section corners to the north and south.

For references, I set four, 5/8" by 24" rebars with 1 1/8" orange plastic caps attached, stamped WTS and 56295LS as described below:

- an iron rebar bears N84°42'23"W, 49.60 feet ;
- an iron rebar bears N80°31'11"W, 27.50 feet;
- an iron rebar bears S1°34'38"E, 22.44 feet;
- an iron rebar bears S0°50'09"E, 45.05 feet;

The monument and references were tied using a Trimble R7/R8 RTK GPS.

Location and comments

Compass Declination

Surveyors Seal

RECEIVED BY:
Umatilla County Surveyor
 Date: 10-07
 Rec'd By: KK
 No. 07-268-B

Firm / Agency
 Witness Tree Surveying
 Address
 P.O. Box G
 Pilot Rock, Or. 97868
 Party Chief
 Stephen K, Haddock

REGISTERED
 PROFESSIONAL
 LAND SURVEYOR

Stephen K. Haddock

OREGON
 JULY 9, 2001
 STEPHEN K. HADDOCK
 56295LS

RENEWAL DATE 6-30-09