

**OREGON CORNER RESTORATION FORM**

Section 36 Township 1S Range 31E  
 County Umatilla Date: March 16, 2011

Corner Designation: 1S31X25

Common quarter corner to S36, R31E and S31, R32E,  
 Township 1 South, W.M., Umatilla County, Oregon.

Previous Renewals / Surveys, etc.


Corner originally set by David P. Thompson under contract No. 106 dated August 16, 1864.  
 His record reads: Set stone 24x8x8 for 1/4 Sec. Cor. L.E. Macomber, in the survey in the record  
 of private surveys Book 1, Page 443 says "stone 1/4 corner".

Monument and Accessories found: ( condition and source )

I found a basalt stone 18x12x4 inches plainly marked 1/4 in place in a north - south fence.


Condition Report Only  
 Not found  
 Remonumented  
 Unrecorded  
 Surveyed in  
 Referenced out

**DIAGRAM**

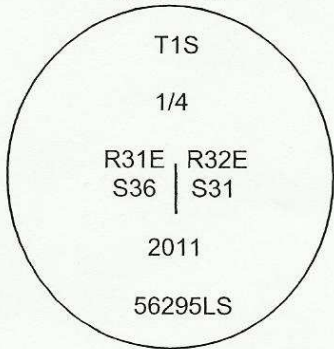

- ⊗ = Set Brass Cap
- = Set Iron Rebar Reference

**SKETCH**

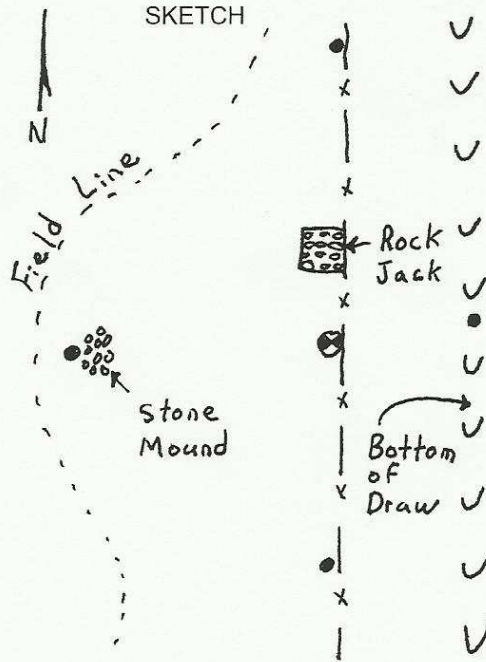

**MONUMENT (S) AND ACCESSORIES SET (Procedures and Description)**

At the position of the found stone I set a 2 3/8" brass cap on a 1 1/2x30" galvanized iron pipe flush with the surface of the ground.

For references, I set four 5/8" by 24" rebars with 1.25" orange plastic caps stamped WTS and 56295LS as described below:

- an iron rebar bears N04°49'13"W, 48.58 feet under the fence;
- an iron rebar bears N63°23'10"E, 25.75 feet near the center of the draw;
- an iron rebar bears S00°31'22"W, 49.32 feet under the existing fence;
- an iron rebar bears S83°16'31"W, 24.97 feet on the west side of a small mound of stones;

The monument and references were tied using a Trimble R7/R8 RTK GPS system.

Location and comments

Compass Declination

Surveyors Seal

RECEIVED BY:  
 Umatilla County Surveyor  
 Date: \_\_\_\_\_  
 Rec'd By: \_\_\_\_\_  
 No. 11-112-c

Firm / Agency  
 Witness Tree Surveying  
 Address  
 P.O. Box G  
 Pilot Rock, OR 97868  
 Party Chief  
 Stephen K, Haddock

REGISTERED  
 PROFESSIONAL  
 LAND SURVEYOR

*Stephen K. Haddock*

OREGON  
 JULY 9, 2001  
 STEPHEN K. HADDOCK  
 56295LS

RENEWAL DATE 6-30-13