

OREGON CORNER RESTORATION FORM

Section 3 Township 1S Range 34E
 County Umatilla Date: July 29, 1997

Corner Designation: 1S34E15

Quarter corner to sections 3 and 10, T1S, R34E W.M.

Condition Report Only
 Not found
 Remonumented
 Unrecorded
 Surveyed in
 Referenced out


Previous Renewals / Surveys, etc.

Corner originally set by Currin and Nolan under special contract dated May 4, 1887.
 His record reads: Set post, 3 ft. long, 3 ins. sq., 2 ft. in ground, marked 1/4 S. on N. face, for 1/4 Sec. Cor, from which a pine, 12 ins. diam., bears N. 50° E., 220 lks. dist. marked 1/4 S. B. T.;

Monument and Accessories found: (condition and source)

Found traces of rotted stake under a stone mound, from which a Ponderosa Pine stump, of correct size and vintage bears N45°35'E, 144.50 feet.

A K tag on a post of a north-south fence across the road gives the record bearing and distance to the witness tree.

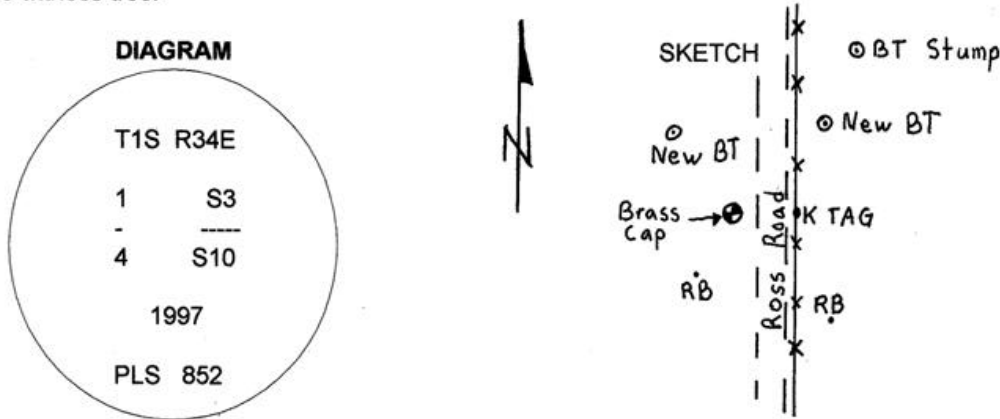

MONUMENT (S) AND ACCESSORIES SET (Procedures and Description)

Set a 1 1/4" x 30" Galvanized Iron Pipe with a 2 1/2" brass cap stamped as shown in the diagram above at the position of the rotted stake. The cap is 6" above the surface of the ground with a collar of stone.

For references, I set two 5/8" by 24" rebars with 1.25" red plastic caps stamped ORLS 852 and WALS 13922 as described below:

- a rebar bears S29°20'W, 35.78 feet in a stone mound;
- a rebar bears S44°11'E, 66.21 feet in a stone mound.

I also set two bearing trees as described below:

- A 8" diameter Ponderosa Pine bears N22°40'E, 76.00 feet scribed 1/4 S3 BT.
- A 13" diameter Ponderosa Pine bears N51°32'E, 98.65 feet scribed 1/4 S3 BT.

The bearing trees have a 1 1/4 inch brass washer stamped ORLS852 and WALS13922 nailed between the letters B and T.

Monument and reference locations were surveyed with theodolite from two GPS control points. The bearings and distances are true

Location and comments

Compass Declination

Surveyors Seal

RECEIVED BY:
Umatilla County Surveyor
 Date: 9-97
 Rec'd By: KK
 No. 97-173-B

Firm / Agency
 Haddock Surveying
 Address
 P.O. Box 1574
 Pendleton, Or. 97801
 Party Chief
 David L. Haddock
 Witness
 Stephen K. Haddock

REGISTERED
 PROFESSIONAL
 LAND SURVEYOR

David L. Haddock

OREGON
 JULY 12, 1988
 DAVID L. HADDOCK
 852