

**CERTIFIED RECORD OF LAND CORNER MONUMENTATION**

**HISTORY OF ORIGINAL CORNER ESTABLISHED:**

Corner originally established by James P. Currin and James E. Noland under their Special Contract dated May 4, 1887. Surveyor General States:

Set a post 48x4x4 ins. 2 ft. in the ground for cor. to sec's. 1,6,7 and 12 mkd. T1S S1 on NW, R34E S12 on SW, S6 on NE, R35E S7 on SE faces with 5 notches on S and 1 on N. edges, from which:

A Fir, 12 ins. in diam. bears S 80°E 21 links dist., marked T1S R35E S7 BT.  
A Pine, 16 ins. in diam. bears N 80°W 21 links dist., R34E S1 BT.

In 1983, Gary L. Langlitz brings this corner to modern standards from the original bearing trees. Umatilla Corner Mounumentation Records State:

At the original corner point established record bearing and distance from the original SE bearing tree, we set a 2"x30" galvanized iron pipe, 26" in the ground along the east side of a N-S logging road and in a N-S fence line with brass cap, marked as shown below. From which:

An 8" Douglas Fir, scribed "T1S R34E S1 BT" on a double blaze bears N35½°W 30.8 ft.  
A 14" Douglas Fir, scribed "X RP BT" on a double blaze bears N 77½°W 68.9 ft.

**DESCRIPTION OF CORNER EVIDENCE FOUND:**

Found a 2 ½" iron pipe with a 2 ½" brass cap 3" above ground marked as shown below.  
Found a 13" snag with scribe marks visible on open blaze bears N 74° W, a distance of 68.9 feet.  
Found a 13" White Fir alive and vigorous with healed blaze bears N 36° W, a distance of 30.8 feet.

**DESCRIPTION OF MONUMENT AND ACCESSORIES I ESTABLISHED TO PERPETUATE THE ORIGINAL LOCATION OF THIS CORNER:**

From the iron pipe monument

**NEW BEARING OBJECTS:**


A 4" White Fir bears N 74° W, a distance of 36.70 feet, marked X BT.

I set a steel fencepost approximately 1 foot North of the corner monument.


I hereby certify that this corner was perpetuated on December 23, 2014.

Witness: Thomas J. Kopp

T 1 S R 34 E E-25

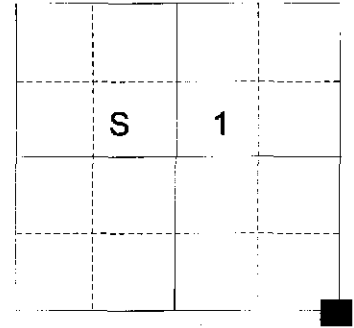

Renewal Date: June 30, 2015

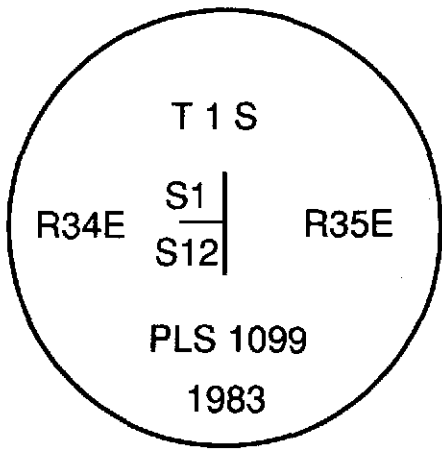

I used a steel tape and magnetic compass in the establishment of the new accessories. I used 16° East declination, the distances are to a 60d spike driven into the right side of the root crown of the new bearing tree. A brass washer marked OPLS 83571 is attached to the BT blaze of the new bearing tree.

15-003-B