

OREGON CORNER RESTORATION FORM

Section 19 Township 1S Range 34E
 County Umatilla Date: April 15, 2016

Corner Designation: 1S34P5

Condition Report Only
 Not found
 Remonumented
 Unrecorded
 Surveyed in
 Referenced out

1/4 corner common to sections 19 and 20 T1S, R34E,
 W.M., Umatilla County, Oregon.


Previous Renewals / Surveys, etc.

Corner was originally set by James. P. Currin and James Noland under special contract dated May 4, 1887. Their record reads: Set a basalt stone 12x10x8 ins., 8 ins. in ground for 1/4 Sec. Cor., marked 1/4 on W. face. Raised mound of stone around it.

Monument and Accessories found: (condition and source)

An unmarked stone of record dimension set in a stone mound with fences running east, west and south.


DIAGRAM

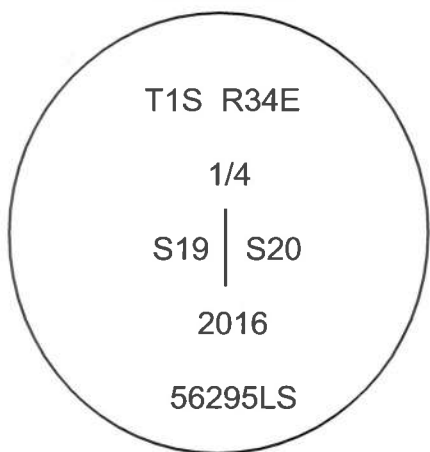

⊗ = Aluminum Cap

• = Rebar Reference

SKETCH

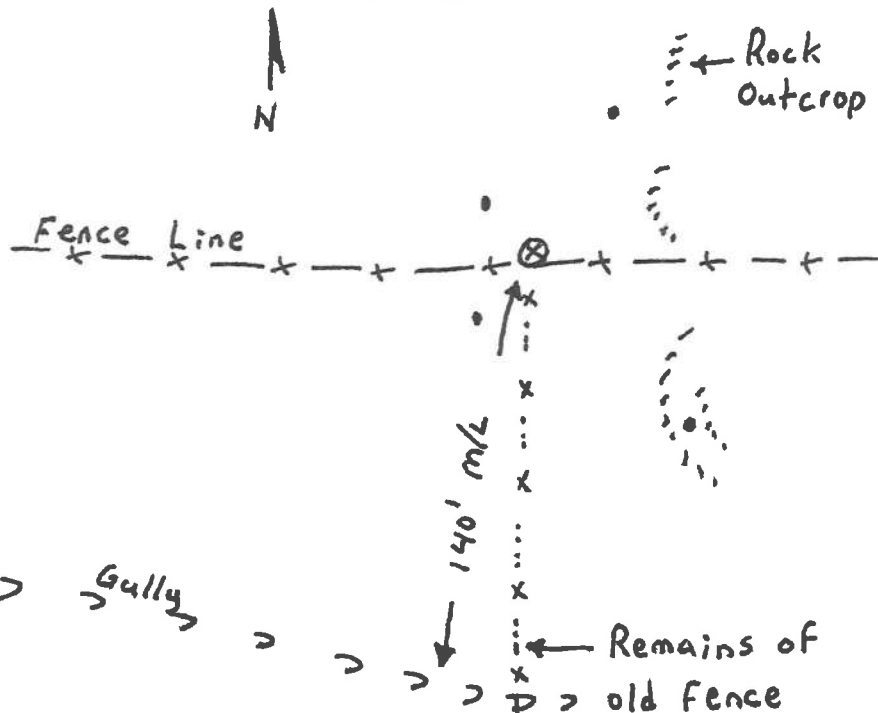

MONUMENT (S) AND ACCESSORIES SET (Procedures and Description)

At the position of the original stone I set a 1"x24" iron rebar with a 2" aluminum cap stamped as shown in the diagram above.

I set four 5/8" x 24" iron rebars with 1 1/8" plastic caps attached as described below:

- a rebar bears N38°55'13"W, 16.23 feet;
- a rebar bears N25°42'27"E, 58.22 feet;
- a rebar bears S61°14'52"E, 42.68 feet in the face of a small rock outcrop;
- a rebar bears S37°14'48"W, 17.61 feet;

Measurements to the cap and references were made with a Trimble RTK GPS system.

Location and comments

Witnessed by:

Compass Declination

Surveyors Seal

RECEIVED BY:
 Umatilla County Surveyor
 Date: 05-31-2016
 Rec'd By: cm. Kofford
 No. 16-067-R
 Survey No. _____

Firm / Agency
 Witness Tree Surveying
 Address
 P.O. Box G
 Pilot Rock, Or. 97868

REGISTERED
 PROFESSIONAL
 LAND SURVEYOR
Stephen K. Haddock
 OREGON
 JULY 9, 2001
 STEPHEN K. HADDOCK
 56295LS
 RENEWS: 6-30-17