


History of original corner establishment:

Original survey by Currin Et Al, under special contract 1887,

Intersect W. bdy. of township 4.23 chains N. of Cor. to Sec's. 1 & 12. Set a post 48x4x4 ins. 2 ft. in the ground for closing cor. to sec's. 6 & 7 from which:

A Pine 24 ins. in dia. bears N 75°E dist. 94 lks. mkd. T1S R35 E 6 BT.

A Pine 12 ins. dia. bears S 85°W dist. 54 lks. mkd. T1S R.34 E S7 BT. No other tree in limits. Raised mound of stone alongside.

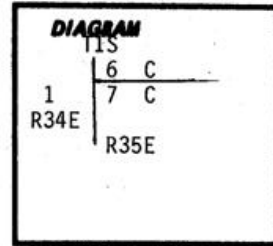


Description of corner evidence found:

Found possible BT, a 16" Western Larch stump, rotted and flush w/surface of ground with tree laying alongside 14" DBH, with scribing "T1S R34E CC BT, on an upper blaze unhealed, and illegible scribing visible on an unhealed lower blaze of apparent same age.

Original notes call for 12" Pine in this quadrant (West of Corner). No trace found of orig. 24" Pine in NE quadrant.

I suspect this possible BT is not orig. Pine. Logging will begin in this area immediately, we reference the center of the 16" Larch stump as shown on accompanying diagram.

Description of monument and accessories established to perpetuate the original location of this corner:

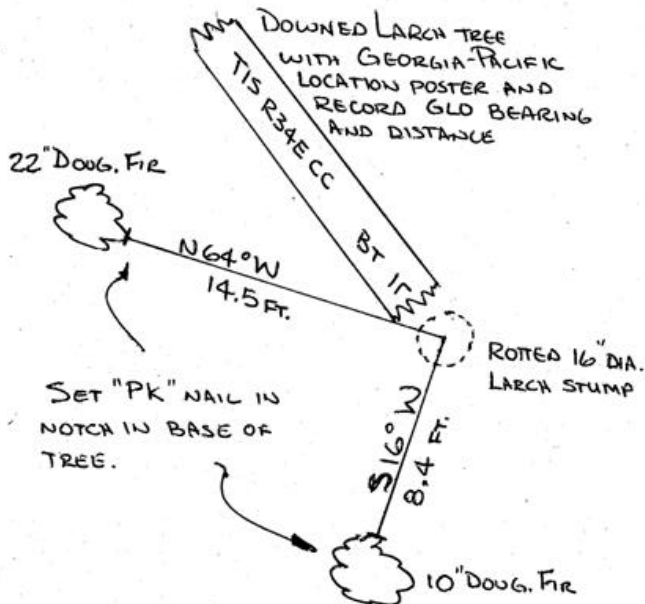

Sept. 27, 1983
WITNESS: Dick Humiston

REGISTERED PROFESSIONAL LAND SURVEYOR
GARY L. LANGLITZ
JULY 22, 1977
1099

State of Oregon I hereby certify that the within instrument was filed in this office
for record on the 11th day of November, 1983
David Krumbein by Betty Cochran
(COUNTY OFFICIAL) (DEPUTY)