

CERTIFIED RECORD OF LAND CORNER MONUMENTATION

HISTORY OF ORIGINAL CORNER ESTABLISHED:

Not previously established.

T 1 S R 35 E U-10

	S	
	28	

DESCRIPTION OF CORNER EVIDENCE FOUND:

None.

DESCRIPTION OF MONUMENT AND ACCESSORIES I ESTABLISHED TO MONUMENT THE ORIGINAL LOCATION OF THIS CORNER:

At position by survey I set a 5/8" x 30" iron pin, 28" in the ground, with 2 1/2" aluminum cap marked as shown below, from which:

NEW BEARING OBJECTS:



A 5/8" x 15" iron pin bears North 85° West a dist. of 9.90 ft., with 1 1/4" aluminum cap marked W RP.

A 5/8" x 15" iron pin bears South 84° East a dist. of 13.05 ft., with 1 1/4" aluminum cap marked E RP.

I hereby certify that the corner was monumented on July 30, 2019.

Witness: Kyle A. Tucker

Falls on the mid to lower third of a steep South aspect.

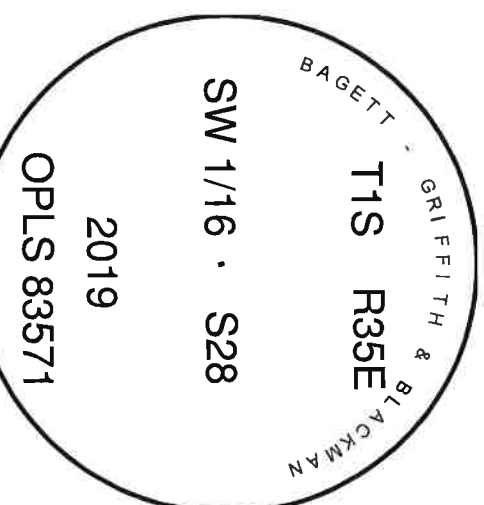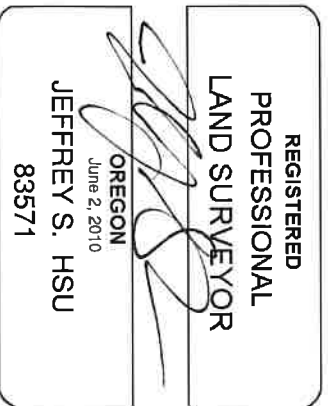

Renewal Date: June 30, 2021

I used a steel tape and magnetic compass in the establishment of the new accessories. I used 13° East declination, the distances and bearings are to the center of the aluminum cap.

U-10

19-079-8