

CERTIFIED RECORD OF LAND CORNER MONUMENTATION

HISTORY OF ORIGINAL CORNER ESTABLISHED:

Not previously established.

T 1 S R 35 E V-10

	S	28	

DESCRIPTION OF CORNER EVIDENCE FOUND:

None.

DESCRIPTION OF MONUMENT AND ACCESSORIES I ESTABLISHED TO MONUMENT THE ORIGINAL LOCATION OF THIS CORNER:

At position by survey I set a 5/8" x 30" iron pin, 27" in the ground, with 2 1/2" aluminum cap marked as shown below, from which:


NEW BEARING OBJECTS:

A 15" Ponderosa Pine bears South 17° East a dist. of 111.95 ft., marked W 1/16 S33 BT, which falls on a spine ridge.


A 10" Douglas Fir bears South 71° West a dist. of 21.20 ft., marked W 1/16 S33 BT.

I hereby certify that the corner was monumented on July 30, 2019.
Witness: Kyle A. Tucker

Falls on a North Aspect.

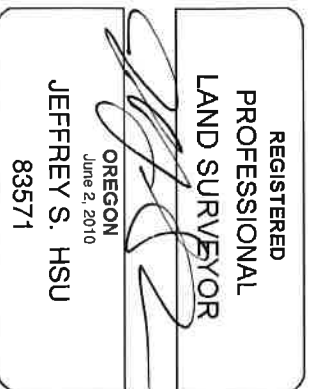

Renewal Date: June 30, 2021

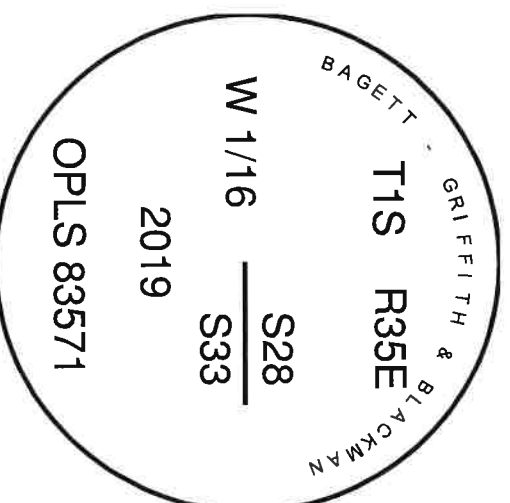

I used a steel tape and magnetic compass in the establishment of the new accessories. I used 13° East declination, the distances are to a 60d spike driven into the right side of the root crown of the bearing trees. A brass washer marked OPLS 83571 is attached to the BT blaze of the new bearing trees.