

**CERTIFIED RECORD OF LAND CORNER MONUMENTATION**


**HISTORY OF ORIGINAL CORNER ESTABLISHED:**

Corner originally established under GLO contract number 451 executed by Rufus S. Moore dated June 12th, 1882. Surveyor General field notes state: Set a post 3 ft. long, 3 ins. sq., 24 ins. in ground for 1/4 sec. cor., marked 1/4 S on W. face from which:

A Spruce 12 ins. in dia. bears N3°W 26 lks. dist. marked 1/4 S BT.

A Spruce 12 ins. in dia. bears S28°E 6 lks. dist. marked 1/4 S BT.

T 1 S R 35 E V-19

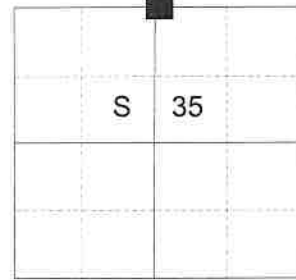

**DESCRIPTION OF CORNER EVIDENCE FOUND:**

None.

**DESCRIPTION OF MONUMENT AND ACCESSORIES I ESTABLISHED TO MONUMENT THE ORIGINAL LOCATION OF THIS CORNER:**

At proportionate position, I set a 2 1/2" aluminum pipe, 27" in the ground, with 3" aluminum cap marked as shown below, from which:

**NEW BEARING OBJECTS:**

A 10" diam. Lodgepole Pine bears North 36° East, a distance of 2.10 feet, marked 1/4 S26 BT.

A 6" diam. Lodgepole Pine bears South 56° East, a distance of 27.30 feet, marked 1/4 S35 BT.


A 8" diam. Lodgepole Pine bears South 7° West, a distance of 5.95 feet, marked 1/4 S35 BT.

A 10" diam. Lodgepole Pine bears North 87° West, a distance of 21.40 feet, marked 1/4 S26 BT.

Set steel fence post approx. 0.5 feet South

Corner falls approx. 5 feet East of Northwesterly/Southeasterly running fence line.

I hereby certify that the corner was monumented on October 16th, 2024.

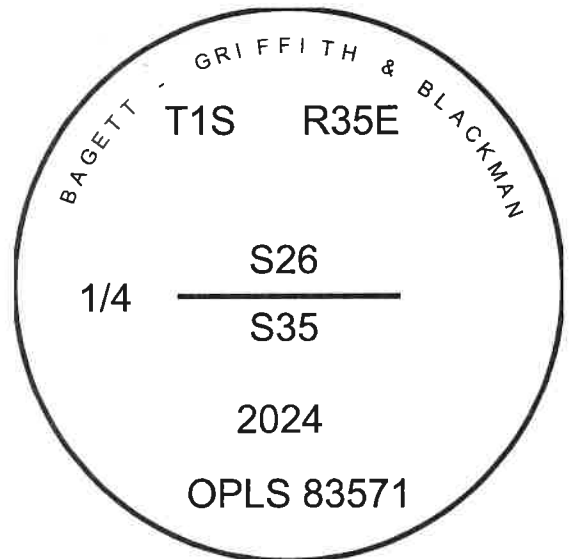

Renewal Date: June 30, 2025

I use a tape and compass with 14° East declination in the establishment of the new bearing trees. Bearings are measured to a brass washer labeled OPLS 83571 nailed to the BT blaze of the base of the tree. Distances are measured to a 60D spike in the right side of the center of the base of the tree.