

USDA-FOREST SERVICE

Index File No. A-15

T 15 R. 36E

Merid. Will

CORNER RECORD (SEARCH)


(Ref. FSM 7151.4)

Tract or Survey No. \_\_\_\_\_ Cor. No. \_\_\_\_\_

R.D. \_\_\_\_\_ County UMATILLA

N.F. UMATILLA State OR

CORNER DIAGRAM

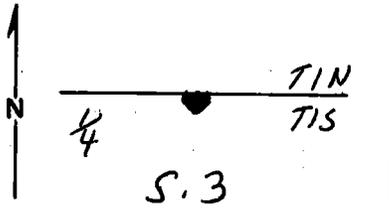

DESCRIBE CORNER MONUMENT FOUND

2 1/2" AL. PIPE WITH 3 1/2" BLM BR. CAP, MKD. →

TIN R36E

453  
TIS R36E  
1984 2

DESCRIBE BEARING TREES OR OTHER OFFICIAL ACCESSORIES FOUND

16" TAM. SCRIBED "453 BT" BEARS 563 1/4" W, 44 LKS.

BLM BR. CAP AT E. 1/8 COR. SEC. 34 BEARS EAST ABOUT 5 1/2 FT.

DESCRIBE CORNER LOCATION RELATIVE TO NEAR-BY FEATURES, ALSO HOW TO REACH CORNER

CORNER LIES ON STEEP, BRUSHY N.W. SLOPE, ABOUT 75 FT. E. OF A DEEP DRAW + CREEK, COURSE N.E. (TAKE YOUR LUNCH WITH YOU)

PHOTO IDENTIFICATION DATA

Photo No. \_\_\_\_\_  
Filed At. \_\_\_\_\_  
Object Ident. \_\_\_\_\_  
Ident. By \_\_\_\_\_  
Signature \_\_\_\_\_

PLANE COORDINATE POSITION DATA

State \_\_\_\_\_ Zone \_\_\_\_\_  
X \_\_\_\_\_  
Y \_\_\_\_\_  
Estab. By \_\_\_\_\_  
Agency \_\_\_\_\_

Signature Victor McJunk Title L.S. Division \_\_\_\_\_ Headquarters \_\_\_\_\_ Date 4-30-86

CORNER RECORD (PERPETUATION)

MONUMENT: DESCRIBE NEW MONUMENT SET, OR WORK DONE TO PRESERVE EXISTING MONUMENT

ACCESSORIES: DESCRIBE NEW BT'S WITNESS OBJECTS ETC. ESTABLISHED, OR WORK DONE TO PRESERVE EXISTING EVIDENCE

ATTACHED SIGN 54-4 TO BT'S  
PAINTED RED BAND AROUND BT'S

SET STEEL POST ABOUT 4 FT. W. OF COR., WITH SIGN 54-9

Work Done By V. McLIND Title LS Date 6-4-86 State Registration No. 934  
or Agency

Certified Cor. Record Prepared? Yes  No  Filed At: \_\_\_\_\_ Date \_\_\_\_\_

REMARKS

Index File No. A-15 T. 15 R. 36E M. Will. Tract or Surv. No. \_\_\_\_\_ Cor. \_\_\_\_\_