


CERTIFIED RECORD OF LAND CORNER MONUMENTATION

History of original corner establishment:  
Corner not previously established.

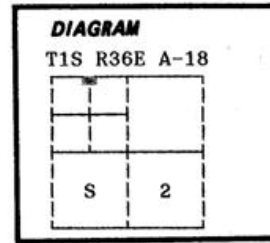

No record of subsequent monumentation found in Umatilla County survey records.

**Description of corner evidence found:**

Corner not previously established.  
See map of survey dated September, 1989.

**Description of monument and accessories established to perpetuate the original location of this corner:** At position determined by survey, I set a 2 1/2" x 30" aluminum pipe with aluminum cap marked as shown, 28 inches in the ground, from which:

New Bearing Objects:  
A 5/8"x30" iron pin with plastic cap marked BGA SURVEY MARKER bears S30°E, 11.36 feet  
A 1/2"x24" iron pin with plastic cap marked BGA MARKER bears S23°W, 11.11 feet

Attached bearing tree signs to the bearing objects.


Set a steel fence post approximately 1 foot East with Land Survey Monument sign attached.

Corner falls 3.42 feet West of the BLM aluminum monument set for the South 1/4 corner of Section 35, T1N R36E (Standard Corner).

Raised a mound of stone around monument, 3 ft. base to top of cap.

I hereby certify that the above corner point was perpetuated as hereon described on September 14, 1989.

Witnesses: Jeff Petersen and Rick Robinson.

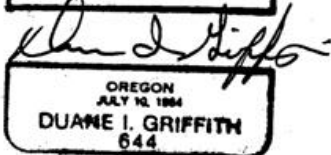

I used a steel tape and magnetic compass in the establishment of new accessories. I used 17° East magnetic declination.

Office of The Survey Dept County of Umatilla  
State of OR I hereby certify that the within instrument was filed in this office for record on the 27 day of October, 1989  
David H. Krumbein by Kathleen L. Amosberry  
(COUNTY OFFICIAL) (DEPUTY)

Form R6-7100-57 (9/71)

RECEIVED BY

Umatilla County Surveyor  
Date 10-89  
Initials KA  
No. 89-101-B

\*GPO-591-971, 1988