

USDA-FOREST SERVICE

Index
File No. A-21

CORNER RECORD (SEARCH)

(Ref. FSM 7151.4)

Tract or
Survey No. _____ Cor.
No. _____


T 1S R. 36E

R.D. WALLA WALLA County UMATILLA

Merid. WILLAMETTE

N.F. UMATILLA State OREGON

CORNER DIAGRAM

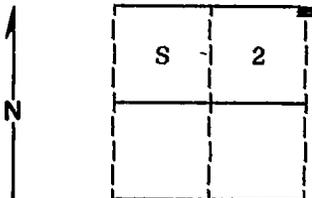

DESCRIBE CORNER MONUMENT FOUND

Found no evidence of the original corner monument.

DESCRIBE BEARING TREES OR OTHER OFFICIAL ACCESSORIES FOUND

Found no evidence of the original corner accessory.

PHOTO IDENTIFICATION DATA

Photo No. _____

Filed At. _____

Object Ident. _____

Ident. By _____

Signature

PLANE COORDINATE POSITION DATA

State _____ Zone _____

X _____

Y _____

Estab. By _____

Agency

Signature

DESCRIBE CORNER LOCATION RELATIVE TO NEAR-BY FEATURES, ALSO HOW TO REACH CORNER

Corner falls on steep West hillside in small brushy draw approximately 800 feet West of a private road (the continuation of the 050 road) and approximately 150 feet North of a ridge.

Title
Surveyor

Division

Headquarters

Date

9-19-89

FS-7100-52 (3/68)

5

CORNER RECORD (PERPETUATION)

MONUMENT: DESCRIBE NEW MONUMENT SET, OR WORK DONE TO PRESERVE EXISTING MONUMENT

Set a 2½"x30" aluminum pipe with aluminum cap marked as shown:
Pipe is set 26 inches in the ground.

Raised a mound of stone around monument, 3 ft. base to top of cap.

T1N	R36E
S 36	
S 2	S 1
T1S	R36E
C C	
1989	
OPLS 644	

ACCESSORIES : DESCRIBE NEW BT^{1/2} WITNESS OBJECTS ETC. ESTABLISHED, OR WORK DONE TO PRESERVE EXISTING EVIDENCE

New Bearing Objects:

A 5/8"x30" iron pin with plastic cap marked BGA SURVEY MARKER bears S80°E, 6.84 feet
A 5/8"x30" iron pin with plastic cap marked BGA SURVEY MARKER bears S12°W, 11.42 feet

Attached bearing tree signs to the bearing objects.

Set a steel fence post approximately 5 feet West with 54-9 and 54-2 signs attached.

10

Work Done By D.I. Griffith Title Surveyor Date 9-14-89 State Registration No. OPLS 644
or Agency

Certified Cor. Record Prepared? Yes No Filed At: Umatilla Co. Surveyor's Office Date 9-89

11

REMARKS

Witnesses: Jeff Petersen and Rick Robinson

Index File No. A-21 T. 1S R. 36E W. M. Tract or Surv. No.

Cor.

12

13

Index File No. A-21


CORNER RECORD (SEARCH)

Tract or Survey No. _____
Cor. No. A-21

T 1 S R. R 36 R.D. Pendleton County Umatilla

Merid. _____ N.F. _____ State Oregon

CORNER DIAGRAM

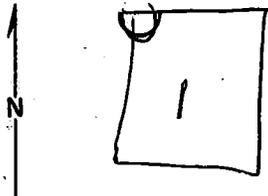

DESCRIBE CORNER MONUMENT FOUND

NONE FOUND

DESCRIBE BEARING TREES OR OTHER OFFICIAL ACCESSORIES FOUND

PHOTO IDENTIFICATION DATA

Photo No. _____
Filed At. _____
Object Ident. _____
Ident. By _____
Signature

PLANE COORDINATE POSITION DATA

State _____ Zone _____
X _____
Y _____
Estab. By _____
Agency

DESCRIBE CORNER LOCATION RELATIVE TO NEAR-BY FEATURES, ALSO HOW TO REACH CORNER

Signature _____

Title _____

Division _____

Headquarters _____

Date _____

7100-52

REV. 65 5



CORNER RECORD (PERPETUATION)

MONUMENT: DESCRIBE NEW MONUMENT SET, OR WORK DONE TO PRESERVE EXISTING MONUMENT

9

ACCESSORIES : DESCRIBE NEW BT's WITNESS OBJECTS ETC. ESTABLISHED, OR WORK DONE TO PRESERVE EXISTING EVIDENCE

10

Work Done By _____ Title _____ Date _____ State Registration No. or Agency _____

Certified Cor. Record Prepared ? Yes No Filed At: _____ Date _____

11

REMARKS

12

Index File No. *A-21* T. R. M. Tract or Surv. No. Cor, 13