

Index
File No. A-5

CORNER RECORD (SEARCH)

(Ref. FSM 7151.4)

Tract or Survey No. A 5

Cor. No. Sec. ~~1~~ 2


T 1 S R. 36 E

R.D. Pendleton County Umatilla

Merid. Willamette

N.F. Umatilla State Oregon

CORNER DIAGRAM

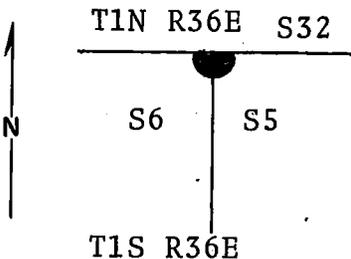

DESCRIBE CORNER MONUMENT FOUND

Set brass cap summer 1972. See reverse side.
Found 14x10x8" basalt stone set in ground in mound of stone marked CC with 5 notches on East and 1 notch on West edges.

DESCRIBE BEARING TREES OR OTHER OFFICIAL ACCESSORIES FOUND

Found down fir, 24" dia. bearing approx. S50°W 32 ft. dist. stone. Blaze grown over.
Found rotten fir log, bearing approx. N15°W 13 ft. dist. from stone.

PHOTO IDENTIFICATION DATA

Photo No. _____
Filed At. _____
Object Ident. _____
Ident. By _____
Signature

DESCRIBE CORNER LOCATION RELATIVE TO NEAR-BY FEATURES, ALSO HOW TO REACH CORNER

Accepted stone as corner position.

PLANE COORDINATE POSITION DATA

State _____ Zone _____
X _____
Y _____
Estab. By _____
Agency



Signature

Title

Division

Headquarters

Date

7100-52 (3/68)

CORNER RECORD (PERPETUATION)

MONUMENT: DESCRIBE NEW MONUMENT SET, OR WORK DONE TO PRESERVE EXISTING MONUMENT

Set a 30x2½" iron pipe with 3" brass cap marked as shown 20" in ground and raised a mound of stone around pipe for the closing corner between sections 5 & 6, from which new BTs:

ACCESSORIES : DESCRIBE NEW BT's WITNESS OBJECTS ETC. ESTABLISHED, OR WORK DONE TO PRESERVE EXISTING EVIDENCE

A ponderosa pine 24" dia. bears N4°W 69.8 ft. dist. marked T1N R36E S32 BT.

A fir 18" dia. bears S85°E 100 ft. dist. marked T1S R36E S5 CC BT.

A ponderosa pine 16" dia. bears S50°W 44 ft. dist. marked T1S R36E S6 CC BT.

Distances taken to a brass washer in the blaze of each tree. Set a steel fence post approx. 5 ft. West from corner with "Attention" sign attached.

~~Used Steel tape & magnetic compass with declination = 20° East.~~

Work Done By D. M. Ferguson Title Land Surveyor Date 7/12/68 State Registration No. 848
or Agency

Certified Cor. Record Prepared ? Yes No Filed At: Umatilla Co. Courthouse Date 11/16/72

REMARKS