

Index File No. B-16

CORNER RECORD (SEARCH)


(Ref. FSM 7151.4)

Tract or Survey No. \_\_\_\_\_ Cor. No. \_\_\_\_\_

T 15 R. 36E R.D. \_\_\_\_\_ County UMATILLA

Merid. WILL. N.F. UMATILLA State OR

CORNER DIAGRAM

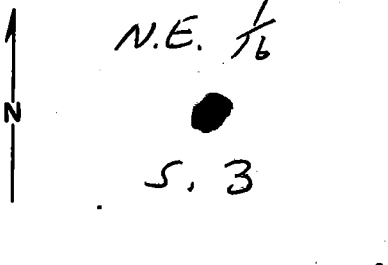

DESCRIBE CORNER MONUMENT FOUND

2 1/2" GALV. IRON PIPE WITH 3 1/2" BLM BR. CAP, MKO. ->

NE 1/4 - S 3  
1984

DESCRIBE BEARING TREES OR OTHER OFFICIAL ACCESSORIES FOUND

18" FIR, SCRIBED "NE 1/4 S 3 BT" BEARS S 3 1/2" W, 3 1/2 LKS.  
12" FIR, SCRIBED "NE 1/4 S 3 BT" BEARS N 89° E, 51 LKS.

PHOTO IDENTIFICATION DATA

Photo No. \_\_\_\_\_  
Filed At. \_\_\_\_\_  
Object Ident. \_\_\_\_\_  
Ident. By \_\_\_\_\_

Signature

PLANE COORDINATE POSITION DATA

State \_\_\_\_\_ Zone \_\_\_\_\_  
X \_\_\_\_\_  
Y \_\_\_\_\_  
Estab. By \_\_\_\_\_  
Agency

DESCRIBE CORNER LOCATION RELATIVE TO NEAR-BY FEATURES, ALSO HOW TO REACH CORNER

COR. LIES ON STEEP, BRUSHY NW SLOPE, IN LIGHT  
TIMBER, ABOUT 150 FT. S. OF A DRAW,  
COURSE N.E.

Signature Vester McInnis Title LS Division \_\_\_\_\_ Headquarters \_\_\_\_\_ Date 4-30-86

CORNER RECORD (PERPETUATION)

MONUMENT: DESCRIBE NEW MONUMENT SET, OR WORK DONE TO PRESERVE EXISTING MONUMENT

9

ACCESSORIES : DESCRIBE NEW BT'S WITNESS OBJECTS ETC. ESTABLISHED, OR WORK DONE TO PRESERVE EXISTING EVIDENCE

ATTACHED SIGN 54-4 TO BT'S  
PAINTED RED BAND AROUND BT'S  
SET STEEL POST ABOUT 5' N. OF CORNER, WITH SIGN 54-9

10

Work Done By. V. McLIND Title LS Date 6-4-86 State Registration No. 934  
or Agency

Certified Cor. Record Prepared ? Yes  No Filed At: \_\_\_\_\_ Date \_\_\_\_\_

11

REMARKS

12

Index File No. B-16 T. 15 R. 36E M. WILL. Tract or Surv. No. \_\_\_\_\_ Cor. \_\_\_\_\_

13