

Index
File No. E-01

CORNER RECORD (SEARCH)

(Ref. FSM 7151.4)

Tract or
Survey No. _____
Cor.
No. _____

T 15 R. 36 E R.D. WALLAWALLA County UMATILLA

Merid. WILLAMETTE N.F. UMATILLA State OREGON

CORNER DIAGRAM



DESCRIBE CORNER MONUMENT FOUND

FND 3" BRASS CAP ON 2 1/2" IRON PIPE RISING
3" ABOVE GROUND

DESCRIBE BEARING TREES OR OTHER OFFICIAL ACCESSORIES FOUND

16" FIR WITH HEALED BLAZE BEARS N 45° W,
25 3/4 FT. 35 1/2" P. PINE, ORIGINAL BT, BLAZED & SCRIBED
T 15 R 36 E S 6 BT, BEARS N° 3 E, 72 LKS., 47.5 FT.
19 1/2" FIR WITH HEALED BLAZE BEARS S. 40° E, 14.2 FT

PHOTO IDENTIFICATION DATA

Photo No. _____
Filed At. _____
Object Ident. _____
Ident. By _____
Signature

DESCRIBE CORNER LOCATION RELATIVE TO NEAR-BY FEATURES, ALSO HOW TO REACH CORNER

In Timber 11 ft. EAST of Fence
From Intersection of Rds 3032 + 3033, 1.25 miles
North to Rd. EAST, 0.9 miles to Road to South east
1.0 miles to Fence, 260 ft South to corner

PLANE COORDINATE POSITION DATA

State _____ Zone _____
X _____
Y _____
Estab. By _____
Agency

Signature Title Division Headquarters Date
D. E. Scott LS1844 _____ _____ 6-23-85
7100-52-(3/68)

CORNER RECORD (PERPETUATION)

MONUMENT: DESCRIBE NEW MONUMENT SET, OR WORK DONE TO PRESERVE EXISTING MONUMENT

NONE

ACCESSORIES : DESCRIBE NEW BT'S WITNESS OBJECTS ETC. ESTABLISHED, OR WORK DONE TO PRESERVE EXISTING EVIDENCE

SET STEEL FENCE POST 3 1/2 FT. NORTH OF CORNER
ATTACHED SIGNS TO POST & BT'S
Painted Red Bands

Work Done By: D.E. SCOTT Title SURVEYOR Date 6-23-85 State Registration No. LS 1844
or Agency

Certified Cor. Record Prepared? Yes No Filed At: _____ Date _____

REMARKS

Index File No. T. R. WM. Tract or Surv. No. Cor. 16
E-01 15 36E 13

Index
File No. E-1

CORNER RECORD (SEARCH)

(Ref. FSM 7151.4)

Tract or
Survey No. E 1

Cor.
No. See

T 1 S R. 36 E


R.D. Pendleton County Umatilla

Merid. Willamette

N.F. Umatilla State Oregon

~~See~~
14

CORNER DIAGRAM

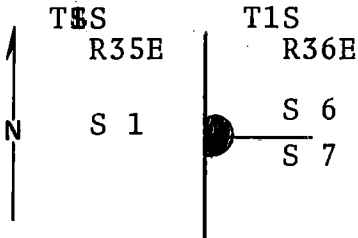

DESCRIBE CORNER MONUMENT FOUND

Set a brass cap summer 1972. See reverse side.

DESCRIBE BEARING TREES OR OTHER OFFICIAL ACCESSORIES FOUND

Found 36" ponderosa pine, living, in good conditon, with scribing clearly visible, bearing N30°E 50 ft. dist. from the corner position.

Found 22" pine down and rotten with scribing clearly visible, bearing N62°W 47.5 ft. dist. from the corner position.

PHOTO IDENTIFICATION DATA

Photo No. _____
Filed At. _____
Object Ident. _____
Ident. By _____
Signature

PLANE COORDINATE POSITION DATA

State _____ Zone _____
X _____
Y _____
Estob. By _____
Agency

DESCRIBE CORNER LOCATION RELATIVE TO NEAR-BY FEATURES, ALSO HOW TO REACH CORNER



Signature

Title

Division

Headquarters

Date

7100-52 (3/68)

CORNER RECORD (PERPETUATION)

MONUMENT: DESCRIBE NEW MONUMENT SET, OR WORK DONE TO PRESERVE EXISTING MONUMENT

Set a 30x2½" iron pipe with brass cap marked as shown, 26 inches in ground and raised a mound of stone around the pipe for the corner ~~between~~ between sections 6 & 7.
From which new BTs:

ACCESSORIES : DESCRIBE NEW BT's WITNESS OBJECTS ETC. ESTABLISHED, OR WORK DONE TO PRESERVE EXISTING EVIDENCE

A fir 18" dia. bears S40°E 14.2 ft. dist. marked T1S, R36E S7 BT.
A fir 14" dia. bears N45°W 25.5 ft. dist. marked T1S R35E S1 BT.
Distances taken to a brass washer in the blaze of each tree.
Set a steel fence post approx. 5 ft North from corner with Forest Boundary sign attached.
Used steel tape and magnetic compass with declination = 20°E.

Work Done By D. M. Ferguson Title Land Surveyor Date 7/12/68 State Registration No. 848
Of Agency _____
Certified Cor. Record Prepared ? Yes No Filed At: Umatilla Co. Courthouse Date 11/16/72

REMARKS

Index File No. T. R. M. Tract or Surv. No. Cor. 12 13