

Index File No. E-11

CORNER RECORD (SEARCH)


(Ref. FSM 7151.4)

Tract or Survey No. _____ Cor. No. _____

T 15 R. 36E R.D. _____ County UMATILLA

Merid. WILL. N.F. UMATILLA State OR

CORNER DIAGRAM

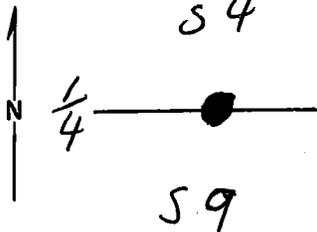

DESCRIBE CORNER MONUMENT FOUND

2 1/2" GALV. IRON PIPE WITH BLM BR. CAP, MKD. →
IN LARGE STONE MOUND

T15 R36E
1/4 S4
59
1984²

DESCRIBE BEARING TREES OR OTHER OFFICIAL ACCESSORIES FOUND

NO BT'S.

PHOTO IDENTIFICATION DATA

Photo No. _____
Filed At. _____
Object Ident. _____
Ident. By _____

Signature

DESCRIBE CORNER LOCATION RELATIVE TO NEAR-BY FEATURES, ALSO HOW TO REACH CORNER

LIES ON SW. SLOPE, ABOUT 150' W. OF
RIDGE TOP, IN OPEN AREA.

PLANE COORDINATE POSITION DATA

State _____ Zone _____
X _____
Y _____
Estab. By _____

Agency

Signature Victor McNeil Title LS.

Division _____

Headquarters _____

Date

8-19-85

ES-7100-52 (3/68)

CORNER RECORD (PERPETUATION)

MONUMENT: DESCRIBE NEW MONUMENT SET, OR WORK DONE TO PRESERVE EXISTING MONUMENT

ACCESSORIES : DESCRIBE NEW BT'S WITNESS OBJECTS ETC. ESTABLISHED, OR WORK DONE TO PRESERVE EXISTING EVIDENCE

SET STEEL POST ABOUT 4 FT. W. OF CORNER, WITH SIGN 54-9

Work Done By. V. Mc LIND Title LS. Date 6-3-86 State Registration No. 934
or Agency

Certified Cor. Record Prepared ? Yes No Filed At: _____ Date _____

REMARKS

Index File No. E-11 T. 1S R. 36E M. WILL. Tract or Surv. No.

Cor.

USDA-FOREST SERVICE

Index

File No. E-11

CORNER RECORD (SEARCH)

(Ref. FSM 7151.4)

Tract or Survey No. _____ Cor. No. E-11


T 1S R. 36E

R.D. Pendleton County Umatilla

Merid. Willamette

N.F. Umatilla State Oregon

CORNER DIAGRAM

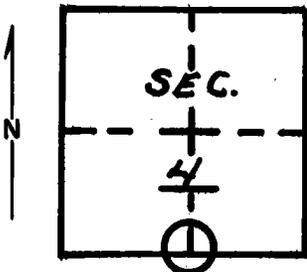

DESCRIBE CORNER MONUMENT FOUND

None

DESCRIBE BEARING TREES OR OTHER OFFICIAL ACCESSORIES FOUND

Several mounds of stone East and West. Mound on top of ridge could be 1/4 cor. but no stone correct size. Strands of very old rusted barbed wire indicating fences East and West thru mounds.

PHOTO IDENTIFICATION DATA

Photo No. _____

Filed At. _____

Object Ident. _____

Ident. By _____

Signature

PLANE COORDINATE POSITION DATA

State _____ Zone _____

X _____

Y _____

Estab. By _____

Agency

Signature
Bill Moore

Title
Eng. Tech.

Division

Headquarters

Date
6/77

7100-52-(3/68)

CORNER RECORD (PERPETUATION)

GPO 902-678

MONUMENT: DESCRIBE NEW MONUMENT SET, OR WORK DONE TO PRESERVE EXISTING MONUMENT

9

ACCESSORIES : DESCRIBE NEW BT'S WITNESS OBJECTS ETC. ESTABLISHED, OR WORK DONE TO PRESERVE EXISTING EVIDENCE

10

Work Done By _____ Title _____ Date _____ State Registration No. or Agency _____

Certified Cor. Record Prepared ? Yes No Filed At: _____ Date _____

11

REMARKS

12

Index File No. T. R. M. Tract or Surv. No. Cor. _____

13