

USDA-FOREST SERVICE

Index
File No. E-12

CORNER RECORD (SEARCH)

(Ref. FSM 7151.4)

Tract or Survey No. _____ Cor. No. _____


T 15 R. 36E

R.D. _____ County UMATILLA

Merid. WILL.

N.F. UMATILLA State OR.

CORNER DIAGRAM:

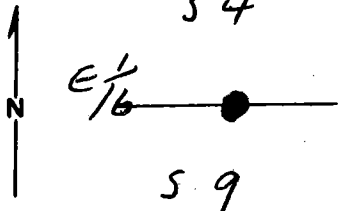

DESCRIBE CORNER MONUMENT FOUND

2 1/2" GALV. IRON PIPE WITH BLM BR. CAP
MKD →

E 1/16 S 4
S 9
1984

DESCRIBE BEARING TREES OR OTHER OFFICIAL ACCESSORIES FOUND

10" TAM. SCRIBED "E 1/16 S 9 BT" BEARS S 26 1/2° W, 10 1/2 LKS.
8" FMR, SCRIBED "E 1/16 S 4 BT" BEARS N 47 1/4° E, 31 1/2 LKS.

PHOTO IDENTIFICATION DATA

Photo No. _____
Filed At. _____
Object Ident. _____
Ident. By _____

Signature

PLANE COORDINATE POSITION DATA

State _____ Zone _____
X _____
Y _____
Estab. By _____

Agency

DESCRIBE CORNER LOCATION RELATIVE TO NEAR-BY FEATURES, ALSO HOW TO REACH CORNER

CORNER LIES IN DEEP CANYON BOTTOM,
ABOUT 25' S.E. OF CREEK, COURSE S.W.

Signature Victor McJunk Title LS

Division

Headquarters

Date 4-23-86 7100-52-(3,68)

CORNER RECORD (PERPETUATION)

MONUMENT: DESCRIBE NEW MONUMENT SET, OR WORK DONE TO PRESERVE EXISTING MONUMENT

ACCESSORIES: DESCRIBE NEW BT'S WITNESS OBJECTS ETC. ESTABLISHED, OR WORK DONE TO PRESERVE EXISTING EVIDENCE

ATTACHED SIGN 54-4 TO BT'S.
PAINTED RED BAND AROUND BT'S
SET STEEL POST ABOUT 4 FT. N. OF COR. WITH SIGN 54-9

Work Done By. V. McLIND Title LS Date 6-4-86 State Registration No. 934
or Agency

Certified Cor. Record Prepared? Yes No Filed At: _____ Date _____

REMARKS

Index File No. E-12 T. 15 R. 36 E M. WILL Tract or Surv. No. _____ Cor. _____