


Index
File No. E-8

CORNER RECORD (SEARCH)
(Ref. FSM 7151.4)

Tract or
Survey No. _____ Cor.
No. _____

T 15 R. 36 E R.D. _____ County UMATILLA
Merid. Will. N.F. UMATILLA State ORE

CORNER DIAGRAM

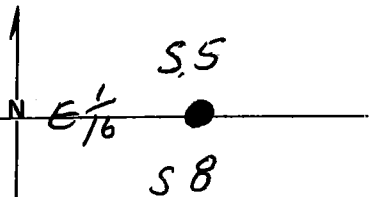

DESCRIBE CORNER MONUMENT FOUND

2 1/2" GALV. IRON PIPE WITH BLM BR. CAP
MKD. AS SHOWN →

E 1/16 S 5
S 8
1984

DESCRIBE BEARING TREES OR OTHER OFFICIAL ACCESSORIES FOUND

20" PINE, SCRIBED E 1/16 S 5 BT, BEARS N 89° W, 134 LBS.

PHOTO IDENTIFICATION DATA

Photo No. _____
Filed At. _____
Object Ident. _____
Ident. By _____

Signature

PLANE COORDINATE POSITION DATA

State _____ Zone _____
X _____
Y _____
Estab. By _____

Agency

DESCRIBE CORNER LOCATION RELATIVE TO NEAR-BY FEATURES, ALSO HOW TO REACH CORNER

COR. LIES ON STEEP, ROCKY, OPEN W. SLOPE

Signature
Nate M. Ford

Title
LS

Division

Headquarters

Date
8-16-85

FS-7100-52 (3/68)

CORNER RECORD (PERPETUATION)

MONUMENT: DESCRIBE NEW MONUMENT SET, OR WORK DONE TO PRESERVE EXISTING MONUMENT

ACCESSORIES : DESCRIBE NEW BT's WITNESS OBJECTS ETC. ESTABLISHED, OR WORK DONE TO PRESERVE EXISTING EVIDENCE

SET STEEL POST APPROX. 3' N. OF CORNER WITH SIGN 54-9

Work Done By. V. McLINO Title LS Date 8-16-85 State Registration No. 934
or Agency

Certified Cor. Record Prepared ? Yes No Filed At: _____ Date _____

REMARKS

Index File No. E-8 T. 15 R. 36E M. WILL Tract or Surv. No. _____ Cor. _____

Index

File No. E-08

CORNER RECORD (SEARCH)

(Ref. FSM 7151.4)

Tract or


Survey No. _____

Cor.

No. _____

T 1S R. 36ER.D. WALLA-WALLA County UMATILLAMerid. W.M.N.F. UMATILLA State OREGON

CORNER DIAGRAM

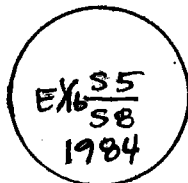↑
N

DESCRIBE CORNER MONUMENT FOUND

FOUND 3 1/4" BLM BRASS CAP ON 2 1/2" IRON PIPE
RISING 6" IN MOUND OF STONES

DESCRIBE BEARING TREES OR OTHER OFFICIAL ACCESSORIES FOUND

20" POND. PINE BLAZED & SCRIBED E 1/16 S8BT
BEARS S89° W ~ (34 LKS - 88 ± FT.)

PHOTO IDENTIFICATION DATA

Photo No. _____

Filed At. _____

Object Ident. _____

Ident. By _____

Signature _____

PLANE COORDINATE POSITION DATA

State _____ Zone _____

X _____

Y _____

Estab. By _____

Agency _____

DESCRIBE CORNER LOCATION RELATIVE TO NEAR-BY FEATURES, ALSO HOW TO REACH CORNER

FOLLOW HORSE HEAVEN RIDGE ROAD (3030090)
TO THE END. CORNER IS ON SW 1/4 SLOPE
& IS VISIBLE FROM ROCK OUT CROPPING TO
THE WEST OF THE END OF ROAD 3030090

Signature

Title

LS 184B

Division

Headquarters

Date

7-85

FS-7100-52 (3/68)

CORNER RECORD (PERPETUATION)

MONUMENT : DESCRIBE NEW MONUMENT SET, OR WORK DONE TO PRESERVE EXISTING MONUMENT

NONE

ACCESSORIES : DESCRIBE NEW BT'S WITNESS OBJECTS ETC. ESTABLISHED, OR WORK DONE TO PRESERVE EXISTING EVIDENCE

SET STEEL FENCE POSTS 4' 50" ? 20' 50".

ATTACHED SIGNS TO POST & BT'S. PAINTED RED BANDS

Work Done By. B.A. SUTTON Title SURVEYOR Date 7-85 State Registration No. LS 1848
or Agency

Certified Cor. Record Prepared ? Yes. No Filed At:

Date

REMARKS

Index File No. E-08 T. 15 R. 36E M. WILLAMETTE Tract or Surv. No.

Cor. 55
E 1/16 38