

Index
File No. H-09

CORNER RECORD (SEARCH)
(Ref. FSM 7151.4)

Tract or
Survey No. _____
Cor.
No. _____


T LS R. 36E

R.D. WALLA WALLA County UMATILLA

Merid. WILLAMETTE

N.F. UMATILLA State OREGON

CORNER DIAGRAM

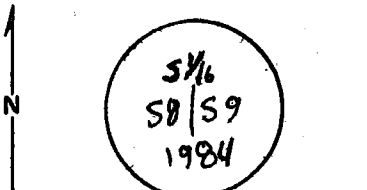

DESCRIBE CORNER MONUMENT FOUND

3/4" BLM BRASS CAP SET FLUSH IN ROCK OUT
CROPPING IN CONCRETE

DESCRIBE BEARING TREES OR OTHER OFFICIAL ACCESSORIES FOUND

6 1/2" P. PINE BLAZED & SCRIBED 5/16 58 BT
BEARS W 58 3/4° W - 71/2 LKS - 47.2 FT
2" P. PINE BLAZED & SCRIBED 5/16 59 BT
BEARS S 55 1/2° E - 148 LKS - 97.7 FT

PHOTO IDENTIFICATION DATA

Photo No. _____
Filed At. _____
Object Ident. _____
Ident. By _____
Signature _____

DESCRIBE CORNER LOCATION RELATIVE TO NEAR-BY FEATURES, ALSO HOW TO REACH CORNER

SEILY END OF HURON SIDING - NEILY
OVER AGAINST TOE OF SLOPE

PLANE COORDINATE POSITION DATA

State _____ Zone _____
X _____
Y _____
Estab. By _____
Agency _____

Signature
[Handwritten Signature]

Title
LS 1848

Division

Headquarters

Date
7-85

CORNER RECORD (PERPETUATION)

MONUMENT: DESCRIBE NEW MONUMENT SET, OR WORK DONE TO PRESERVE EXISTING MONUMENT

NONE

ACCESSORIES : DESCRIBE NEW BT'S WITNESS OBJECTS ETC. ESTABLISHED, OR WORK DONE TO PRESERVE EXISTING EVIDENCE

SET STEEL FENCE POST 3' NORTH
ATTACHED SIGNS TO POST & BT'S. PAINTED RED BANDS.

Work Done By B.A. SUTTON Title SURVEYOR Date 7-85 State Registration No. LS 1248

Certified Cor. Record Prepared? Yes No Filed At: _____ Date _____

REMARKS

Index File No. H-09 T. 1S R. 36E M. WILLAMETTE Tract or Surv. No. Cor. 5 1/6 8/9