

Index File No. J-5

CORNER RECORD (SEARCH)

(Ref. FSM 7151.4)

Tract or Survey No. J 5 Cor. No. Sec

T 1 S R. 36 E


R.D. Pendleton County Umatilla

31

Merid. Willamette

N.F. Umatilla State Oregon

CORNER DIAGRAM

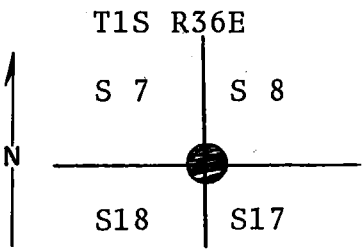

DESCRIBE CORNER MONUMENT FOUND

Set brass cap summer 1972. See reverse side.

DESCRIBE BEARING TREES OR OTHER OFFICIAL ACCESSORIES FOUND

Found 36" ponderosa pine, live in good condition with healed over blaze clearly visible, bearing N10°E 92.3 ft. from the corner position.

Found a 30" ponderosa pine, live in good condition, w with blaze chopped open and scribing clearly visible, bearing N5°W 70 ft. from the corner position.

PHOTO IDENTIFICATION DATA

Photo No. _____
 Filed At. _____
 Object Ident. _____
 Ident. By _____

Signature

PLANE COORDINATE POSITION DATA

State _____ Zone _____
 X _____
 Y _____
 Estab. By _____

Agency

DESCRIBE CORNER LOCATION RELATIVE TO NEAR-BY FEATURES, ALSO HOW TO REACH CORNER



Signature

Title

Division

Headquarters

Date

7100-52 (3/68)

CORNER RECORD (PERPETUATION)

MONUMENT: DESCRIBE NEW MONUMENT SET, OR WORK DONE TO PRESERVE EXISTING MONUMENT

Set a 30x2½" iron pipe with 3" brass cap marked as shown, 28" in the ground for the corner to secs. 7, 8, 18, 17, from which new BTs:

ACCESSORIES : DESCRIBE NEW BT's WITNESS OBJECTS ETC. ESTABLISHED, OR WORK DONE TO PRESERVE EXISTING EVIDENCE

A pine 30" in dia. bears S32°E 60.9 ft. dist. marked T1S R36E S17 BT.

A pine 12" in dia. bears S54°W 138.7 ft. dist. marked T1S R36E S18 BT.

Rescribed original BT - a 36" pine bears N10°E 92.3 ft. dist. marked T1S R36E S8 BT.

Distances taken to a brass washer in the blaze of each tree.

Set a steel fence post approx. 5 ft North from corner with "Attention" sign attached.

~~Used steel tape & magnetic compass with declination = 20° East.~~

Work Done By D.M. Ferguson Title Land Surveyor Date 7/12/68 State Registration No. 848
or Agency

Certified Cor. Record Prepared ? Yes No Filed At Umatilla Co. Courthouse Date 11/16/72

REMARKS