


Index File No. P-9

**CORNER RECORD (SEARCH)**  
(Ref. FSM 7151.4)

Tract or Survey No. \_\_\_\_\_ Cor. No. P-9

T 1 S R. 36 E R.D. Pendleton County Umatilla  
Merid. Willamette N.F. Umatilla State Oregon

CORNER DIAGRAM

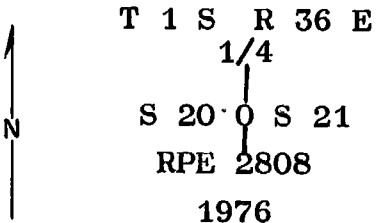

DESCRIBE CORNER MONUMENT FOUND

NONE

DESCRIBE BEARING TREES OR OTHER OFFICIAL ACCESSORIES FOUND

NONE

PHOTO IDENTIFICATION DATA

Photo No. \_\_\_\_\_  
Filed At. \_\_\_\_\_  
Object Ident. \_\_\_\_\_  
Ident. By \_\_\_\_\_  
*Signature*

DESCRIBE CORNER LOCATION RELATIVE TO NEAR-BY FEATURES, ALSO HOW TO REACH CORNER

Corner is 57 feet South of creek which runs NW

PLANE COORDINATE POSITION DATA

State \_\_\_\_\_ Zone \_\_\_\_\_  
X \_\_\_\_\_  
Y \_\_\_\_\_  
Estab. By \_\_\_\_\_  
*Agency*

*James D. Hawley* Signature Title RPE 2808 Division \_\_\_\_\_ Headquarters \_\_\_\_\_ Date 10-20-75 7100-52 (3/68)

CORNER RECORD (PERPETUATION)

MONUMENT: DESCRIBE NEW MONUMENT SET, OR WORK DONE TO PRESERVE EXISTING MONUMENT

Set 2½-inch brass cap on 2-inch iron pipe,  
31 inches long, 6 inches above ground with  
6 ft. steel fence post 3 feet North and  
signs 54-4 and 54-2 attached.

T 1 S R 36 E  
¼  
S 20 | S 21  
RPE 2808  
1976

ACCESSORIES : DESCRIBE NEW BT'S WITNESS OBJECTS ETC. ESTABLISHED, OR WORK DONE TO PRESERVE EXISTING EVIDENCE

A larch 10 " diam., bears S. 47° 30' W., 14.9 ft. dist., mkd ¼ S 20 BT.  
A fir 10" diam., bears S. 53° 30' E., 8.8 ft. dist., mkd. ¼ S 21 BT.

The BTs have sign 54-3 attached 6" below band of red paint and brass washer mkd. RPE 2808 nailed flush with BT blazes.

Work Done By Jas. D. Hanley Title Engr. Date 5-20-76 State Registration No. RPE 2808  
Or Agency

Certified Cor. Record Prepared ? Yes XXX Filed At: Pendleton, Oregon Date 8/ /76

REMARKS

There are several rotted stumps in the immediate area that have been sawed but no accessory evidence could be identified.