


Index  
File No. Q-09

CORNER RECORD (SEARCH)  
(Ref. FSM 7151.4)

Tract or  
Survey No. \_\_\_\_\_  
Corner  
No. \_\_\_\_\_

T LS R. 36 E R.D. WALLA WALLA County UMATILLA  
Merid. WM N.F. UMATILLA State OREGON

CORNER DIAGRAM

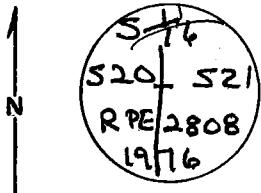

DESCRIBE CORNER MONUMENT FOUND

FND 2 1/2" BRASS CAP ON IRON PIPE RISING  
6" ABOVE GROUND

DESCRIBE BEARING TREES OR OTHER OFFICIAL ACCESSORIES FOUND

9" FIR, HEALED BLAZE, BEARS S 12 1/2° W.  
4.5 FT.

8 1/2" FIR, HEALED BLAZE, BEARS N 42° E  
12 1/2 FT

PHOTO IDENTIFICATION DATA

Photo No. \_\_\_\_\_  
Filed At. \_\_\_\_\_  
Object Ident. \_\_\_\_\_  
Ident. By \_\_\_\_\_  
*Signature*

PLANE COORDINATE POSITION DATA

State \_\_\_\_\_ Zone \_\_\_\_\_  
X \_\_\_\_\_  
Y \_\_\_\_\_  
Estab. By \_\_\_\_\_  
*Agency*

DESCRIBE CORNER LOCATION RELATIVE TO NEAR-BY FEATURES, ALSO HOW TO REACH CORNER

ON NORTH SLOPE  
FROM BUTCHERED POINT TURN AROUND  
500' NORTH TO POSTED LINE THEN 630'  
EAST TO CORNER

*Signature*  
D. Scott

*Title*  
LS 1844

*Division*

*Headquarters*

*Date*

7-2-85

CORNER RECORD (PERPETUATION)

MONUMENT, DESCRIBE NEW MONUMENT SET, OR WORK DONE TO PRESERVE EXISTING MONUMENT

NONE

ACCESSORIES : DESCRIBE NEW BT'S WITNESS OBJECTS ETC. ESTABLISHED, OR WORK DONE TO PRESERVE EXISTING EVIDENCE

SET STEEL FENCE POSTS 1.3 FT. SOUTH & 40° EAST OF CORNER.

ATTACHED SIGNS TO POSTS & BT'S

Work Done By A. ESCOTT Title SURVEYOR Date 7-85 State Registration No. LS 1844 or Agency

Certified Cor. Record Prepared? Yes  No  Filed At:

Date \_\_\_\_\_

REMARKS

Index File No.

T.

R.

WM.

Tract or Surv. No.

Q-09

15

36E

Tract or Surv. No. S 1/16 Cor. S20/S21


Index **Q-9**  
 File No. \_\_\_\_\_

**CORNER RECORD (SEARCH)**  
 (Ref. FSM 7151.4)

Tract or Survey No. \_\_\_\_\_  
 Cor. No. **Q-9**

T **1 S** R. **36 E** R.D. **Pendleton** County **Umatilla**  
 Merid. **Willamette** N.F. **Umatilla** State **Oregon**

CORNER DIAGRAM

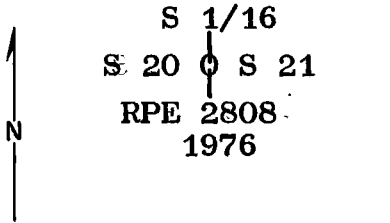

DESCRIBE CORNER MONUMENT FOUND

None, never established

DESCRIBE BEARING TREES OR OTHER OFFICIAL ACCESSORIES FOUND

None

PHOTO IDENTIFICATION DATA

Photo No. \_\_\_\_\_  
 Filed At. \_\_\_\_\_  
 Object Ident. \_\_\_\_\_  
 Ident. By \_\_\_\_\_  
*Signature*

DESCRIBE CORNER LOCATION RELATIVE TO NEAR-BY FEATURES, ALSO HOW TO REACH CORNER

Corner is on slight bench 100 feet South of a draw and about 400 feet below Butcher Point.

PLANE COORDINATE POSITION DATA

State \_\_\_\_\_ Zone \_\_\_\_\_  
 X \_\_\_\_\_  
 Y \_\_\_\_\_  
 Estab. By \_\_\_\_\_  
*Agency*

*J. M. Stanley*

Title **ORPE 2808** Division \_\_\_\_\_ Headquarters \_\_\_\_\_ Date **5-20-76**  
 7100-52 (3/68)

CORNER RECORD (PERPETUATION)

MONUMENT: DESCRIBE NEW MONUMENT SET, OR WORK DONE TO PRESERVE EXISTING MONUMENT

Set a 2½-inch brass cap on a 2-inch iron pipe 31-inches long, 6 inches above ground in earth and rock mound with 6 ft. steel fence post alongside and signs 54-4 and 54-2 attached. See below for monument marking:

ACCESSORIES : DESCRIBE NEW BT'S WITNESS OBJECTS ETC. ESTABLISHED, OR WORK DONE TO PRESERVE EXISTING EVIDENCE

A fir 7" diam., bears N 42° E, 12.4 ft. dist.,  
mkd. S 1/16 S 21 BT.

T 1 S R 36 E  
S 1/16

A fir 10" diam. bears S 14° 30' W, 4.5 ft. dist.,  
mkd. S 1/16 S 20 BT.

S 20 S 21  
RPE 2808  
1976

The BTs have sign 54-3 attached 6" below band of red paint and brass washer marked RPE 2808 nailed flush with BT blades.

10

Work Done By Jas. D. Hanley Title Engr. Date 5/20/76 State Registration No. ORPE 2808  
or Agency

Certified Cor. Record Prepared ? Yes  No Filed At: Pendleton, Ore. Date 8/ /76

11

REMARKS

Index File No. Q-9 T. 1 S R. 36 E WM.

Tract or Surv. No.

Cor.

12

13