

Index File No. V-5

CORNER RECORD (SEARCH)


(Ref. FSM 7151.4)

Tract or Survey No. _____ Cor. No. _____

T 1S R. 36E R.D. Pendleton County Umatilla

Merid. Willamette N.F. Umatilla State Oregon

CORNER DIAGRAM

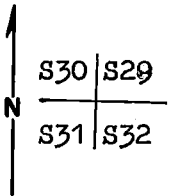

DESCRIBE CORNER MONUMENT FOUND

2 1/2" Gal. steel pipe with a 3" Brass cap properly stamped, firmly set in a mound of stone.

DESCRIBE BEARING TREES OR OTHER OFFICIAL ACCESSORIES FOUND

Orig. 14" now 24" Wh. Fir S20E-25 lks. (to face) nearly healed blaze partially opened-face rotted away.
Orig. 24" now down and rotted 18" Larch S35W-41 lks. - no marks remain.

PHOTO IDENTIFICATION DATA

Photo No. 480-207
Filed At. Umatilla N.F.
Object Ident. Two I.P.'s
Ident. By Larry D. Bishop
Signature

DESCRIBE CORNER LOCATION RELATIVE TO NEAR-BY FEATURES, ALSO HOW TO REACH CORNER

Orig. 8" Fir now possible stump hole.
PLS 848 14" Fir now 15" Wh. Fir N37E, 21.5 ft. nearly healed **double blaze. (con't)**

PLANE COORDINATE POSITION DATA

State _____ Zone _____
X _____
Y _____
Estob. By _____
Agency

PLS 848 8" Fir now 9" D-Fir S7E, 25.2 ft. nearly healed double blaze.
PLS 848 12" Fir now 12" Wh. Fir S44W, 22.5 ft. nearly healed double blaze. (con't on back)

From I-84 follow Rd. 31 Northeast 1.3 miles to dirt spur left.
Follow spur Northwest 1/4 mile to tag on left. Corner is 10 chains West in creek bottom.

Signature
Larry D. Bishop

Title Land Surveyor Division _____ Headquarters _____ Date 10/82
7100-52-(3/68)

CORNER RECORD (PERPETUATION)

MONUMENT: DESCRIBE NEW MONUMENT SET, OR WORK DONE TO PRESERVE EXISTING MONUMENT

(con't)

PLS 848 10" now 11" Fir N43W, 21.7 ft. healed double blaze.

Distances to blaze

Guard post West with sign 54-4.

ACCESSORIES: DESCRIBE NEW BT'S WITNESS OBJECTS ETC. ESTABLISHED, OR WORK DONE TO PRESERVE EXISTING EVIDENCE

Work Done By Larry D. Bishop Title Surveyor Date 10/82 State Registration No. 896
or Agency

Certified Cor. Record Prepared? Yes No Filed At: _____ Date _____

REMARKS

Added signs 54-4 and BT as necessary to BT's and painted band and blazes red.

Index File No. T. R. M. Tract or Surv. No. Cor. 12 13

Index File No. V-5

CORNER RECORD (SEARCH)
(Ref. FSM 7151.4)

Tract or Survey No. V 5


Cor. No. 70
Sec. 30

T 1S R. 36 E

R.D. Pendleton County Umatilla

Merid. Willamette N.F. Umatilla State Oregon

CORNER DIAGRAM

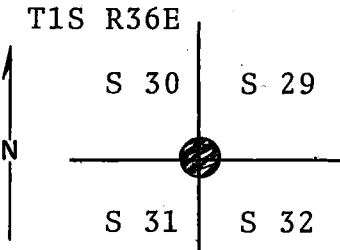

DESCRIBE CORNER MONUMENT FOUND

Brass cap set ~~summer~~ 1972. See reverse side.

DESCRIBE BEARING TREES OR OTHER OFFICIAL ACCESSORIES FOUND

Found 30" fir with blaze closed. bearing S20°E 16.5 ft. dist. from corner position.

Found down and rotten tamarack with blaze face visible, rotten stump bearing S35°W 27 ft. dist. from the corner position.

Found rotten fir stump with original ax marks visible

DESCRIBE CORNER LOCATION RELATIVE TO NEAR-BY FEATURES, ALSO HOW TO REACH CORNER
bearing N70°W 15.2 ft. dist. from the corner position.

Found original blaze lines East and West.

PHOTO IDENTIFICATION DATA

Photo No. _____
Filed At. _____
Object Ident. _____
Ident. By _____
Signature

PLANE COORDINATE POSITION DATA

State _____ Zone _____
X _____
Y _____
Estab. By _____
Agency



Signature

Title

Division

Headquarters

Date

7100-52 (3/68)

CORNER RECORD (PERPETUATION)

MONUMENT: DESCRIBE NEW MONUMENT SET, OR WORK DONE TO PRESERVE EXISTING MONUMENT

Set 30x2½" iron pipe with 3" brass cap marked as shown 24" in the ground for the corner to sections 29, 30, 31, & 31, from the evidence shown above and raised a mound of stone around the pipe.

From which new BTs:

A fir 14" dia. bears N37°E 21.5 ft. dist. marked T1S R36E S29 BT.

9

ACCESSORIES : DESCRIBE NEW BT'S WITNESS OBJECTS ETC. ESTABLISHED, OR WORK DONE TO PRESERVE EXISTING EVIDENCE

A fir 8" dia. bears S7°E 25.2 ft. dist. marked T1S R36E S32 BT.

A fir 12" dia. bears S44°W 22.5 ft. dist. marked T1S R36E S31 BT.

A fir 10" dia. bears N43°W 21.7 ft. dist. marked T1S R36E S 30 BT/

All distances taken to a brass washer in the blaze of each tree.

Set a steel fence post approx. 5 ft. West with an "Attention" sign attached.

Used a steel tape & magnetic compass with declination equal to 20°E.

10

Work Done By D.M. Ferguson Title Land Surveyor Date 7/12/68 State Registration No. 848
or Agency

Certified Cor. Record Prepared ? Yes No Filed At: Umatilla Co. Courthouse Date 11/16/72

11

REMARKS

12

Index File No. V-5 T. R. M. Tract or Surv. No. Cor. 13