

USDA-FOREST SERVICE

Index File No. X - 113

CORNER RECORD (SEARCH)

(Ref. FSM 7151.4)

Tract or Survey No. \_\_\_\_\_ Cor. No. \_\_\_\_\_


T 15 R. 36 E

R.D. \_\_\_\_\_ County UNION

Merid. WILLAMETTE

N.F. UMATILLA State OREGON

CORNER DIAGRAM

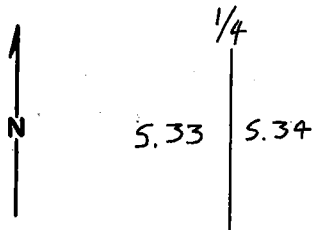

DESCRIBE CORNER MONUMENT FOUND

DESCRIBE BEARING TREES OR OTHER OFFICIAL ACCESSORIES FOUND

FOUND AXE WORK ON OLD BURNT FACE, TREE IS SE BT.

PHOTO IDENTIFICATION DATA

Photo No. \_\_\_\_\_

Filed At. \_\_\_\_\_

Object Ident. \_\_\_\_\_

Ident. By \_\_\_\_\_

Signature \_\_\_\_\_

PLANE COORDINATE POSITION DATA

State \_\_\_\_\_ Zone \_\_\_\_\_

X \_\_\_\_\_

Y \_\_\_\_\_

Estab. By \_\_\_\_\_

Agency \_\_\_\_\_

DESCRIBE CORNER LOCATION RELATIVE TO NEAR-BY FEATURES, ALSO HOW TO REACH CORNER

AT MT. EMILY TURNOFF, GO NORTH ON F.R. 31, 4 MILES, TURN BACK LEFT ON PRIMITIVE ROAD, GO NORTH 0.5 MILES TO 2ND. 4'X4" POST ON LT., SEE TAG ON POST. FOLLOW POSTED BOUNDARY NORTH 1400 FEET TO COR. IN TAMARACK STAND.

Signature

*Clayton J. Marks*

Title

LAND SURVEYOR

Division

Headquarters

Date

SEPT. 14, 1982

7100-52-(3/68)

**CORNER RECORD (PERPETUATION)**

**MONUMENT:** DESCRIBE NEW MONUMENT SET, OR WORK DONE TO PRESERVE EXISTING MONUMENT  
 SET A 2 1/2" DIAM. BRASS CAP, MARKED PER SKETCH, IN A 2"x30" IRON PIPE  
 AT RECORD DISTANCE FROM THE B.T. WHICH IS A 12" D.B.H. TAMARACK,  
 DOWN AND BADLY ROTTED.

T15 R36E  
 1/4  
 S33/S34  
 RPLS 1910  
 1982

9

**ACCESSORIES:** DESCRIBE NEW BT'S WITNESS OBJECTS ETC. ESTABLISHED, OR WORK DONE TO PRESERVE EXISTING EVIDENCE

- ① A 8" D.B.H. TAMARACK N. 55°30' W., 29.9', SCRIBED 1/4 S33 BT.
  - ② A 10" D.B.H. TAMARACK N. 22°E, 33.3', SCRIBED 1/4 S34 BT.
- BOTH HAVE BRASS WASHER RPLS 1910 BETWEEN B & T.

10

Work Done By G.J. MARTIN Title LAND SURVEYOR Date 9-14-82 State Registration No. \_\_\_\_\_  
 or Agency \_\_\_\_\_

Certified Cor. Record Prepared?  Yes No Filed At UMATILLA COUNTY SURV. OFF. Date 9-82

11

REMARKS

12

8/26/69  
**CORNER RECORD (SEARCH)**  
 (Ref. FSM 7151.4)

Tract or  
 Survey No. \_\_\_\_\_

LL  
 Cor. No. X-13 29

Index File No. X-13


T 1 S. R. 36 E.

R.D. Pendleton County Umatilla

Merid. Willamette

N.F. Umatilla State Oregon

CORNER DIAGRAM

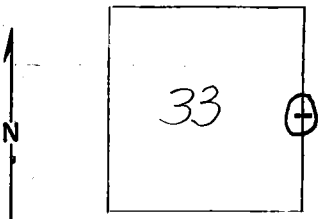

DESCRIBE CORNER MONUMENT FOUND

None found.

2

DESCRIBE BEARING TREES OR OTHER OFFICIAL ACCESSORIES FOUND

None found.

6

PHOTO IDENTIFICATION DATA

Photo No. EQO(9/9/67)25-8

Filed At. \_\_\_\_\_

Object Ident. ---

Ident. By ---

*Signature*

7

DESCRIBE CORNER LOCATION RELATIVE TO NEAR-BY FEATURES, ALSO HOW TO REACH CORNER

Located area to be searched on aerial photo by projecting between the known NE & SE corners of sec. 33.

Found a Boise Cascade loc. poster stating that if at approx. cor.; & 2" diam. post 2' high with top painted red found near by.

3

PLANE COORDINATE POSITION DATA

State \_\_\_\_\_ Zone \_\_\_\_\_

X \_\_\_\_\_

Y \_\_\_\_\_

Estab. By \_\_\_\_\_

*Agency*

8



4

Signature  
**Ken Magoon**

Title  
**Eng. Aid**

Division  
**U.S.F.S.; Umatilla N.F.; S.O.**

Headquarters

Date  
**17 Sept. 1969**

7100-52 (3/68)

5

CORNER RECORD (PERPETUATION)

MONUMENT: DESCRIBE NEW MONUMENT SET, OR WORK DONE TO PRESERVE EXISTING MONUMENT

-----

ACCESSORIES : DESCRIBE NEW BT'S WITNESS OBJECTS ETC. ESTABLISHED, OR WORK DONE TO PRESERVE EXISTING EVIDENCE

-----

Work Done By Mike Lilly Title Eng. Aid Date \_\_\_\_\_ State Registration No. \_\_\_\_\_ or Agency \_\_\_\_\_

Certified Cor. Record Prepared ? Yes  No  Filed At: \_\_\_\_\_ Date \_\_\_\_\_

REMARKS

There is a blazed line with blazes (painted red) from NE cor. of sec. 33 to the E. 1/4 cor. & it appears that the line runs on south to the SE cor. of Sec. 33.

Index File No. X-13 T. 1 S. R. 36 E. M. Willamette Tract or Surv. No. \_\_\_\_\_ Cor. X-13