


**CERTIFIED RECORD OF LAND CORNER MONUMENTATION**

**HISTORY OF ORIGINAL CORNER ESTABLISHED:**

Corner originally established by Herman Gradon under GLO Contract No. 452, dated June 16, 1882. Surveyor General field notes state:

- Set a basalt stone 16x10x8 ins 11 ins in the ground. for 1/4 sec cor. marked 1/4 on W face. From which
- A pine 10 ins diam. bears N.30°E. 24 lks dist. marked 1/4 S BT
- A pine 10 ins diam. bears N.85°W. 19 lks dist. Marked 1/4 S BT

T 1 S R 36 E X-05

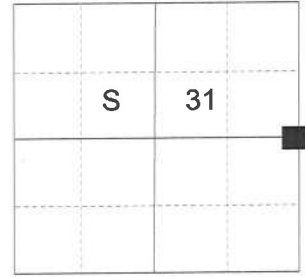

**DESCRIPTION OF CORNER EVIDENCE FOUND:**

None

**DESCRIPTION OF MONUMENT AND ACCESSORIES I ESTABLISHED TO PERPETUATE THE ORIGINAL LOCATION OF THIS CORNER:**

At proportioned position, I set a 2 1/2" x 30" aluminum pipe with a 2 1/2" aluminum cap marked as shown below, 25" in the ground, with a collar of stone 18" diameter. From which:

**NEW BEARING OBJECTS:**

- A 5" White Fir bears South 86° East, a distance of 3.50 feet, marked X BT.
- An 8" Lodgepole Pine bears South 49° East, a distance of 12.75 feet, marked 1/4 S32 BT.
- A 19" White Fir bears South 3° West, a distance of 16.50 feet, marked 1/4 S31 BT.
- A 5" Lodgepole Pine bears North 20° West, a distance of 14.45 feet, marked 1/4 S31 BT.

Corner monument falls approximately 40 feet South of Mt. Emily Rd.


I set a steel fencepost approximately 1 foot North of corner monument.

I hereby certify that the corner was monumented on April 30, 2015.

Witness: Thomas J. Kopp



Renewal Date: June 30, 2017

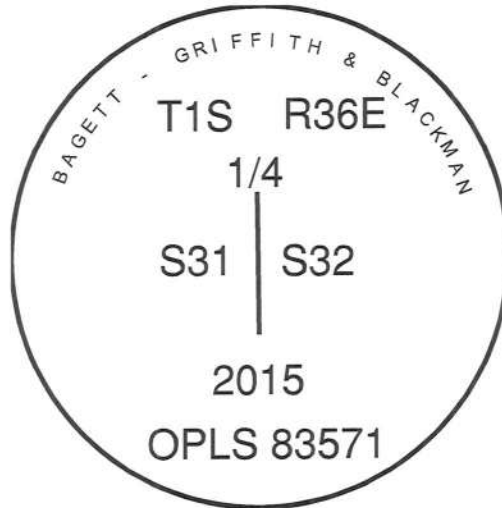

I used a steel tape and magnetic compass in the establishment of the new accessories. I used 16° East declination, the distances are to a 60d spike driven into the right side of the root crown of the bearing trees, spike in left side of the root crown of the Southeast Lodgepole pine bearing tree. A brass washer marked OPLS 83571 is attached to the BT blaze of the new bearing trees.

**X-05**

15-036-B