

USDA-FOREST SERVICE

Index
File No. E-1

CORNER RECORD (SEARCH)

(Ref. FSM 7151.4)

Tract or
Survey No. _____ Cor.
No. _____


T 1S R. 37E

R.D. Walla Walla County Umatilla

Merid. Willamette

N.F. Umatilla State Oregon

CORNER DIAGRAM

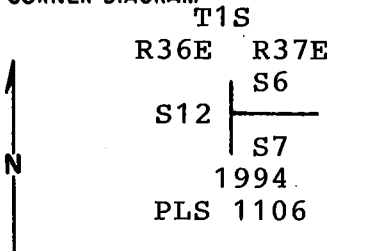

DESCRIBE CORNER MONUMENT FOUND

None. Corner re-established by single proportionate measure, using U.S. Deputy Surveyor, Henry Meldrum's record, from contract no. 450, dated June 10, 1882.

DESCRIBE BEARING TREES OR OTHER OFFICIAL ACCESSORIES FOUND

None.

PHOTO IDENTIFICATION DATA

Photo No. _____
Filed At. _____
Object Ident. _____
Ident. By _____
Signature

DESCRIBE CORNER LOCATION RELATIVE TO NEAR-BY FEATURES, ALSO HOW TO REACH CORNER

Corner falls on slight Southwesterly slope. Timber East and West has been partially cut. Logging road is 600-700' East of corner on knob.

PLANE COORDINATE POSITION DATA

State _____ Zone _____
X _____
Y _____
Estob. By _____
Agency

Signature
Willie R. Wells

Title PLS Division _____ Headquarters PENDLETON Date 11/3/94 FS-7100-52 (3/68)

1
2
3
4
5

CORNER RECORD (PERPETUATION)

MONUMENT: DESCRIBE NEW MONUMENT SET, OR WORK DONE TO PRESERVE EXISTING MONUMENT

2 1/2" aluminum cap on 2 1/2" x 30" aluminum pipe - 25" in the ground, with mound of earth to cap, marked as shown in diagram. Set steel fence post with signs 54-2 and 54-9 attached, 2.6 feet South of monument.

ACCESSORIES : DESCRIBE NEW BT'S WITNESS OBJECTS ETC. ESTABLISHED, OR WORK DONE TO PRESERVE EXISTING EVIDENCE

A 5/8" x 30" iron pin with yellow plastic cap bears N44°E-23.3 feet. A 5/8" x 30" iron pin with yellow plastic cap bears N84 3/4°E-15.9 feet. A 5/8" x 30" iron pin with yellow plastic cap bears S68°E-34.1 feet. A 5/8" x 30" iron pin with yellow plastic cap bears S34°E-23.4 feet. Attached sign 54-3 to iron pins, and sign 54-9 to steel fence posts set near iron pins.

Work Done By WR Wells Title PLS Date _____ State Registration No. or Agency PLS 1106

Certified Cor. Record Prepared? Yes No _____ Filed At: UMATILLA COUNTY SURVEYOR'S OFFICE Date 12/94

REMARKS

This corner was monumented as part of a USFS contract.

Index File No. T. R. M. Tract or Surv. No. Cor. 12 13
E1 1S 37E Willamette