


Index
 File No. G-1
 T 1S R. 37E
 Merid. Willamette

CORNER RECORD (SEARCH)

(Ref. FSM 7151.4)

R.D. Walla Walla County Umatilla
 N.F. Umatilla State Oregon

Tract or
 Survey No. Cor.
 No.

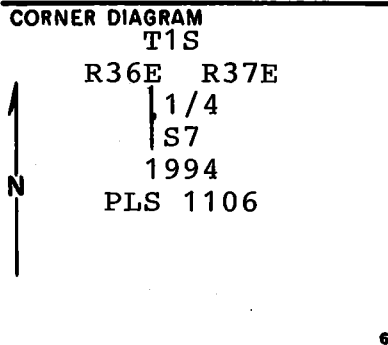

DESCRIBE CORNER MONUMENT FOUND

None. This corner was established by section subdivision. Corner was set at the midpoint between the Northwest and Southwest corners of Section 7 and on the East line of Sec. 12.

DESCRIBE BEARING TREES OR OTHER OFFICIAL ACCESSORIES FOUND

None.

PHOTO IDENTIFICATION DATA
 Photo No.
 Filed At.
 Object Ident.
 Ident. By
 Signature

DESCRIBE CORNER LOCATION RELATIVE TO NEAR-BY FEATURES, ALSO HOW TO REACH CORNER

Corner is approximately 350 feet North of gate at USFS road no. 3113-040. Corner falls on South-westerly slope in scattered timber.

PLANE COORDINATE POSITION DATA
 State Zone
 X
 Y
 Estab. By
 Agency

Signature Walt R. Webb Title PLS Division Headquarters PENDLETON Date 11/3/94 FS-7100-52 (3/68)

CORNER RECORD (PERPETUATION)

MONUMENT: DESCRIBE NEW MONUMENT SET, OR WORK DONE, TO PRESERVE EXISTING MONUMENT

2½" aluminum cap on a 2½" x 30" aluminum pipe, 25" in the ground, with a mound of earth to cap, marked as shown in diagram. Set steel fence post with 54-2 and 54-9 signs attached, 1.7 feet South of monument.

ACCESSORIES : DESCRIBE NEW BT'S WITNESS OBJECTS ETC. ESTABLISHED, OR WORK DONE TO PRESERVE EXISTING EVIDENCE

A 23" pine bears N56°E-58.2 feet, scribed: ¼ S7 BT.
 An 11" douglas fir bears S63 1/4°E-48.7 feet, scribed: ¼ S7 BT.
 A 22" white fir bears S31 1/2°E-38.3 feet, scribed: ¼ S7 BT.
 A 21" white fir bears S11°E-76.6 feet, scribed: ¼ S7 BT.
 New bearing trees have a brass washer stamped 'PLS 1106' nailed to the face of the blaze. Attached 54-3 and 54-9 signs, painted 6" red band and face of blaze red.

Work Done By. WR Wells Title PLS Date _____ State Registration No. PLS 1106
 or Agency _____

Certified Cor. Record Prepared? Yes No _____ Filed At: UMATILLA COUNTY SURVEYOR'S OFFICE Date 12/94

REMARKS

This corner was monumented as part of a USFS contract.

Index File No.	T.	R.	M.	Tract or Surv. No.	Cor.
G1	1S	37E	Willamette		13