

USDA-FOREST SERVICE

Index

File No. N-05

**CORNER RECORD (SEARCH)**

(Ref. FSM 7151.4)

Tract or Survey No. \_\_\_\_\_ Cor. No. \_\_\_\_\_


T 1S R. 37E

R.D. WALLA WALLA County UMATILLA

Merid. WILLAMETTE

N.F. UMATILLA State OREGON

**CORNER DIAGRAM**

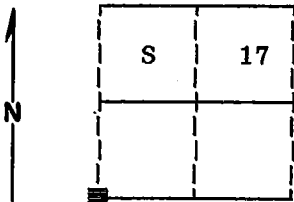

**DESCRIBE CORNER MONUMENT FOUND**

Found no evidence of the original corner monument.

**DESCRIBE BEARING TREES OR OTHER OFFICIAL ACCESSORIES FOUND**

Found a stump hole N47°E, 39 lks.  
 Found a 15 inch diameter Fir snag S70°E,  
 41 lks, dead 10 ft. high snag with BT scribe visible.  
 Found a 36 inch diameter Ponderosa Pine S20°W,  
 29 lks, dead and down on face.  
 Found a stump hole N50°W, 77 lks.

**PHOTO IDENTIFICATION DATA**

Photo No. 12 616140A 787-149

Filed At. Ranger Office

Object Ident. Bearing Tree

Ident. By D. I. Griffith  
*Signature*

**PLANE COORDINATE POSITION DATA**

State \_\_\_\_\_ Zone \_\_\_\_\_

X \_\_\_\_\_

Y \_\_\_\_\_

Estab. By \_\_\_\_\_

**DESCRIBE CORNER LOCATION RELATIVE TO NEAR-BY FEATURES, ALSO HOW TO REACH CORNER**

Corner falls on very steep brushy East face approximately 150 feet above dry ravine and approximately 4500 feet West of the 3113 road.

*Signature*

Title \_\_\_\_\_  
Surveyor

Division \_\_\_\_\_

Headquarters \_\_\_\_\_

Date 9-19-89

FS-7100-52 (3/68)

4  
5

**CORNER RECORD (PERPETUATION)**

MONUMENT: DESCRIBE NEW MONUMENT SET, OR WORK DONE TO PRESERVE EXISTING MONUMENT

Set a 2½"x30" aluminum pipe with aluminum cap marked as shown:  
 Pipe is set 28 inches in the ground.

T1S	R37E
S 18	S 17
-----	
S 19	S 20
1989	
OPLS 644	

ACCESSORIES : DESCRIBE NEW BT'S WITNESS OBJECTS ETC. ESTABLISHED, OR WORK DONE TO PRESERVE EXISTING EVIDENCE

New BTs:

A 9 inch diameter Douglas Fir bears N8°E, 28.64 feet marked T1S R37E S17 BT  
 A 12 inch diameter Douglas Fir bears S27°E, 55.50 feet marked T1S R37E S20 BT  
 A 14 inch diameter Douglas Fir bears S50°W, 46.8 feet marked T1S R37E S19 BT  
 A 8 inch diameter Douglas Fir bears N60°W, 22.0 feet marked X BT  
 Painted a 6 inch red band around all bearing trees and attached 54-3 and 54-9 signs.

Set a steel fence post approximately 5 feet North with 54-9 sign attached.

Work Done By D.I. Griffith Title Surveyor Date 8-27-89 State Registration No. OPLS 644  
 or Agency

Certified Cor. Record Prepared ? Yes  No Filed At: Umatilla Co. Surveyor's Office Date 9-89

REMARKS

Index File No. N-05 T. 1S R. 37E W.M.

Tract or Surv. No.

Cor.

USDA-FOREST SERVICE

Index File No. N-5

CORNER RECORD (SEARCH)

(Ref. FSM 7151.4)

Tract or Survey No. \_\_\_\_\_ Cor. No. \_\_\_\_\_


T 1S R. 37E

R.D. WALLA WALLA County UMATILLA

Merid. WILL

N.F. UMATILLA State OREGON

CORNER DIAGRAM

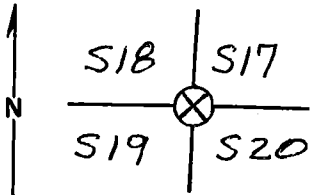

DESCRIBE CORNER MONUMENT FOUND

NONE

DESCRIBE BEARING TREES OR OTHER OFFICIAL ACCESSORIES FOUND

A 14" x 6' HIGH FIR SNAG WITH DOUBLE HEALED BLAZES, I OPEN LOWER BLAZE & FIND SCRIBES "BT", BEARS S70°E, 41 LINKS,

ORIG. 36" PINE IS DOWN & LYING ON BLAZED FACE, STUMP HOLE BEARS S20°W, 29 LINKS.

DESCRIBE CORNER LOCATION RELATIVE TO NEAR-BY FEATURES, ALSO HOW TO REACH CORNER

THE OTHER TWO ORIGINAL BT'S ARE GONE, I PLACED B.T. SIGNS ON BOTH BT'S & A LOCATION POSTER ON A 5" FIR 35 FT. NORTH OF CORNER,

PHOTO IDENTIFICATION DATA

Photo No. \_\_\_\_\_

Filed At. \_\_\_\_\_

Object Ident. \_\_\_\_\_

Ident. By \_\_\_\_\_

Signature

PLANE COORDINATE POSITION DATA

State \_\_\_\_\_ Zone \_\_\_\_\_

X \_\_\_\_\_

Y \_\_\_\_\_

Estab. By \_\_\_\_\_

Agency

Signature

Title

Division

Headquarters

Date

FS-7100-52 (3/68)

Dennis L. Hayford

PLS 1636

S.O.

APRIL 15, 1986

4

5

**CORNER RECORD (PERPETUATION)**

**MONUMENT: DESCRIBE NEW MONUMENT SET, OR WORK DONE TO PRESERVE EXISTING MONUMENT**

9

**ACCESSORIES : DESCRIBE NEW BT'S WITNESS OBJECTS ETC. ESTABLISHED, OR WORK DONE TO PRESERVE EXISTING EVIDENCE**

10

**Work Done By** \_\_\_\_\_ **Title** \_\_\_\_\_ **Date** \_\_\_\_\_ **State Registration No. or Agency** \_\_\_\_\_

**Certified Cor. Record Prepared ?** Yes No **Filed At:** \_\_\_\_\_ **Date** \_\_\_\_\_

11

**REMARKS**

12

**Index File No.**      **T.**      **R.**      **M.**      **Tract or Surv. No.**      **Cor.**

13