

OREGON CORNER RESTORATION FORM

COUNTY: Umatilla. DATE: 04/21/17.

CORNER DESIGNATION: E-3, The North one-quarter corner of Section 7, Township 2 North, Range 28 East, W.M..

PREVIOUS RENEWALS/SURVEYS ETC: Corner originally established by David P. Thompson Contract No. 83 dated July 22, 1859. Notes state: Set post corner for 1/4 Sec. corner in mound of earth & as per instructions. The corner was reestablished by John Kimbrell, Deputy County Surveyor, in Survey No. 357, recorded at Record of Private Survey Book 2, Page 216, in December, 1912. Kimbrell reports setting a marked square wood post 18" in the ground at the corner point.

MONUMENT AND ACCESSORIES FOUND: None. Reestablished by proportional measure between the reestablished Northeast and Northwest corners of Section 7.

MONUMENT MARKING DETAIL:

T2N R28E
S6
1/4 -----
S7
2017
PLS 1106

MONUMENT SET: Corner falls in the County Road in a soft area build up with rock. Attempted to set a brass cap monument but hit rock 20" down. At the corner point, set a 5/8 by 15" rebar with 2" aluminum cap, with cap 6" below road surface. Cap is marked as shown in "Monument Marking Detail".

New accessories:

A 3/4" brass washer stamped "PLS 1106" set in 1' above ground line in UECA power pole No. 75900 bears S 72° E, 137.2 feet.

A 5/8" by 24" rebar with 1 1/4" red plastic cap bears S 80° W, 47.2 feet.

A 5/8" by 24" rebar with 1 1/4" red plastic cap bears S 41° E, 21.9 feet.

A 5/8" by 24" rebar with 1 1/4" red plastic cap bears S 10° W 15.4 feet.

The red plastic caps are marked "ORPLS 1106 WAPLS 17372". All rebar accessories have "bearing object" signs wired to them. Nailed "bearing object" sign to power pole with brass washer. Set steel fence post 10' South of corner monument with "Witness" sign wired to it.

LOCATION AND COMMENTS: Corner is located 6 inches beneath Eagle Ranch Road.

FIRM: Wells Surveying
P.O. Box 1696
Pendleton, OR 97801


COMPASS DECLINATION: 18° East

Surveyor's Seal

\2N28E3



William R. Wells

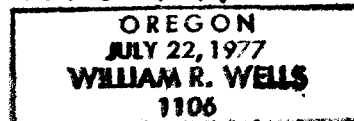

renews 6-30-18

17-065-C