

OREGON CORNER RESTORATION FORM

Section 36 Township 3N
County Umatilla Date: 05/24/10

Range 29E

Corner Designation: 3N29Z23

1/4 Corner common to section 36 T3NR29E, 1 T2NR29E.

_____	Condition Report Only
X_____	Not Found
X_____	Re monumented
_____	Unrecorded
X_____	Surveyed In
X_____	Referenced Out


Previous Renewals / Surveys, etc.

Originally Surveyed by Gates in 1859. He set a post in a mound of earth.


Monuments and Accessories Found: (Condition and Source)

None.

Diagram

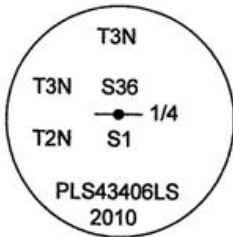

Sketch

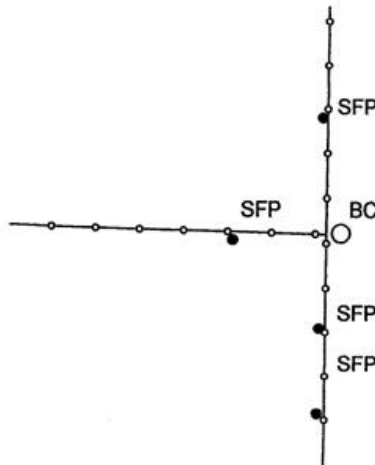

NAD 83/91
OREGON STATE PLANE NORTH
INTERNATIONAL FEET

N740661.43
E8551630.96

LAT - 45° 41' 24.37605" N
LON - 119° 07' 55.69219" W

Monument (s) Set (Procedures and Description)

1 1/2" x 30" Galvanized iron pipe with a 2 1/2" Brass cap monument, stamped as shown above. I held the old existing fence intersection as best evidence.

References Set:

- A 5/8" x 30" Iron rebar w/rpc #43406 lies S 01°40' W, 23.51'
- A 5/8" x 30" Iron rebar w/rpc #43406 lies S 01° W, 39.34'
- A 5/8" x 30" Iron rebar w/rpc #43406 lies N 86° W, 21.21'
- A 5/8" x 30" Iron rebar w/rpc #43406 lies N 02°20' W, 19.12'

Location and Comments

The only way to get to this corner is through Cunningham Sheep Co.'s Nolan Ranch access roads from the South.

Compass Declination

17° E

Surveyors Seal

REGISTERED
PROFESSIONAL
LAND SURVEYOR

Robert D. English
OREGON
JANUARY 11, 2005
ROBERT DOUGLAS ENGLISH
43406LS

RENEWAL DATE: 12/31/11

RECEIVED BY:

Date: 6-10
Rec'd By: KK
No. 10-104-R

Firm / Agency

Survey One, LLC.
P.O. Box 382
Pendleton, OR 97801
(541) 276-2055