

CERTIFIED RECORD OF LAND CORNER MONUMENTATION

L-9

Restoration of 1/4 cor. 17/16 T.2 N.R.32 EWM

L9


History of original corner establishment:

Post and mound set by Daniel Chaplin under contract No. 107, dated September 21, 1864

Post and mound set by Zenas F. Moody under contract No. 165, dated October 4, 1871.

Stone set by James P. Currin & James Noland under special contract dated May 4, 1887. Stone described as being 9x8x7 in. with "1/4" scribed on west face.

Survey by W.E.O. Criger, dated March 1951 shows "I.P. found"

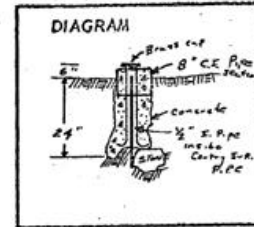


Description of corner evidence found:

A 1/2 "x32" iron pipe was found 4" below surface of ground and a stone 9x8x7 inches with 1/4 scribed on its side was found near the base of the pipe. The records called for "1/4" to be on west side of stone, but was found to be on the bottom.

Pictures of the iron pipe & stone are on file at City Engineer's Office.

Description of monument and accessories established to perpetuate the original location of this corner

The iron pipe was referenced and the stone checked for "1/4" markings. The stone was replaced in its found position and reburied. A Umatilla County surveyors brass cap and pipe was placed over the 1/2" iron pipe and set in concrete. The Brass cap is stamped "1/4 COR 17/16" and punched for position from the reference hubs.

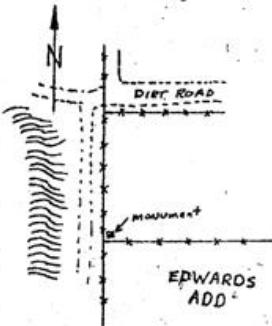

SUBMITTED BY CITY ENGINEERING DEPT.  
Pendleton, Oregon



*James L. Chaffee*  
City Engineer

Office of County Surveyor County of Umatilla  
State of Oregon, I hereby certify that the within instrument was filed in this office  
for record on the 2 day of April, 1970, at 11 o'clock P.M., (signed)  
*Ralph S. Thompson* by \_\_\_\_\_ (DEPUTY)  
(COUNTY OFFICIAL)