

**OREGON CORNER RESTORATION FORM**

Section 3 Township 1N Range 32E  
County Umatilla Date: April 1, 2010

Corner Designation: 1N32A15

- Condition Report Only
- Not found
- Remonumented
- Unrecorded
- Surveyed in
- Referenced out


Common quarter corner to section 34, T2N, R32E and section 3, T1N, R32E, W.M., Umatilla County, Oregon.

Previous Renewals / Surveys, etc.

Corner originally set by David P. Thompson under contract #106 dated August 16, 1864. His record reads: Set post for 1/4 sec. corner. Zenas Moody under contract 164 dated October 4, 1871 states: Set post and made earth mound for 1/4 sec. cor. James Currin and James Noland under special instructions dated May 4, 1887 state: Found old mound for 1/4 sec. cor. Set a basalt stone 9x8x7 ins in old mound, marked 1/4 on N. face.

Monument and Accessories found: ( condition and source )  
None. This point falls in the McKay Reservoir.

**DIAGRAM**

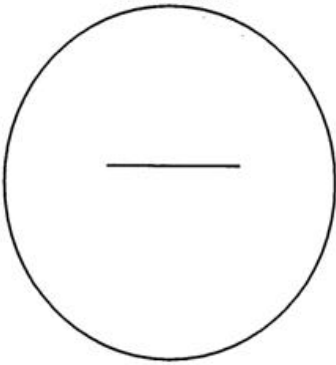

**SKETCH**

MONUMENT (S) AND ACCESSORIES SET (Procedures and Description)  
None. This certificate is to report the state plane coordinates only.

Location and comments  
NAD 83/1991 State Plane Coordinate  
Oregon North Zone.  
N = 710,198.08 ift  
E = 8,637,939.99 ift

Compass Declination

Surveyors Seal

RECEIVED BY:  
Umatilla County Surveyor  
Date: 6-10  
Rec'd By: [Signature]  
No. 10-95-c

Firm / Agency  
Witness Tree Surveying  
Address  
P.O. Box G  
Pilot Rock, Or. 97868  
Party Chief  
Stephen K, Haddock

REGISTERED  
PROFESSIONAL  
LAND SURVEYOR

*Stephen K. Haddock*

OREGON  
JULY 9, 2001  
STEPHEN K. HADDOCK  
56295LS

RENEWAL DATE 6-30-11